

# KANSAS

Form 51-5M-7-39-Palace


Russell

Section 28 Township 14 Range 13-W

Well No. #4 Geise

Company R. H. Shelds

NORTH Hall Pool

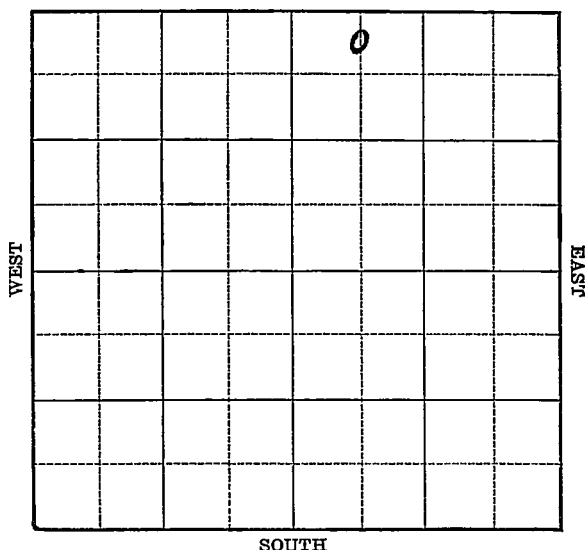

Sec. 28 Twp. 14 R. 13-W

Well No. #4 Geise Farm

R. H. Shields Company

(Hall)


330 Ft. from N. Line

\_\_\_\_\_ Ft. from S. Line

\_\_\_\_\_ Ft. from E. Line

660 Ft. from W. Line

Elev. 1754

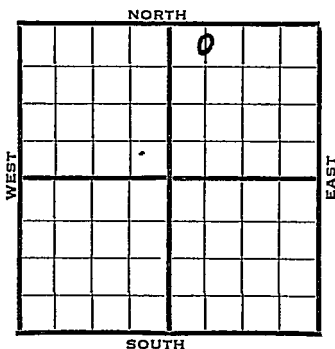

1940	REPORT
3/27	R.O.G.
4/4	"
4/12	"
4/18	"
4/25	R.U. cable.
5/2	20" - 25' 15 1/2" - 63' <del>12 1/2" x 38'</del>
	12 1/2" - 387' Drlg. 560'
5/9	Anhy 690' 10" - 700'
	Drlg. 1500'
5/16	Well flowed estimated 100 bbls.
	2320-25' Shut down.
	"hink in Tarkio.
5/22	Tarkio 2250'
	Oil 2320-25'
	8" - 2275'
	T.D. 2325'
	66' of 6" liner 2320'
	Potential 2294 bbls., flow.
	<b>COMPLETED</b>

Map No. 72 Sec. 28 Twp. 14 R. 13WWell No. 4 GieseR.H.Shields

Company

Contractor

**COMPLETED****SECTION PLAT**

		o	

C N L NW NE

330 Ft. from N. Line

Ft. from S. Line

Ft. from E. Line

660 Ft. from W. Line

Hall Pool

Location \_\_\_\_\_

Rig up \_\_\_\_\_

Drilling and Remarks:

*Marked 2250**Oil 2320-25**8" @ 2275**66'-6" hole 2320**Flow. 2294 BX.***RECORD**

Cased \_\_\_\_\_ in., \_\_\_\_\_ ft.

Sand \_\_\_\_\_

Gas \_\_\_\_\_

Oil \_\_\_\_\_

Total Depth 2325**PRODUCTION**

1st 24 hrs. Nat. \_\_\_\_\_

1st 24 hrs. after shot \_\_\_\_\_

Gas \_\_\_\_\_ Cu. Ft.

Dry Hole \_\_\_\_\_

Abandoned \_\_\_\_\_

Date

MAY 22 1940 19S. J. LEWIS Scout

Map No. 72 Sec. 28 Twp. 14 R. 13WWell No. 4 GeiseR. H. Shields Company

Contractor

## FIRST REPORT

C N L NW NE

330 Ft. from N. Line

\_\_\_\_\_ Ft. from S. Line

\_\_\_\_\_ Ft. from E. Line

660 Ft. from W. Line

HALL POOL

## SECTION PLAT

		o	

Location \_\_\_\_\_

Rig up \_\_\_\_\_

Drilling and Remarks:

ROG

## RECORD

Cased \_\_\_\_\_ in., \_\_\_\_\_ ft.

Sand \_\_\_\_\_

Gas \_\_\_\_\_

Oil \_\_\_\_\_

Total Depth \_\_\_\_\_

## PRODUCTION

1st 24 hrs. Nat. \_\_\_\_\_

1st 24 hrs. after shot \_\_\_\_\_

Gas \_\_\_\_\_ Cu. Ft.

Dry Hole \_\_\_\_\_

Abandoned \_\_\_\_\_

Date

MAR 27 1940 19

S. J. LEWIS

Scout