

KANSAS

Russell


FORM 51 5M 4-41 PETROL

Section 28 Township 14 Range 13-W

Well No. #5 Giese

Company R. H. Shields et al

NORTH Hall Gurney Pool

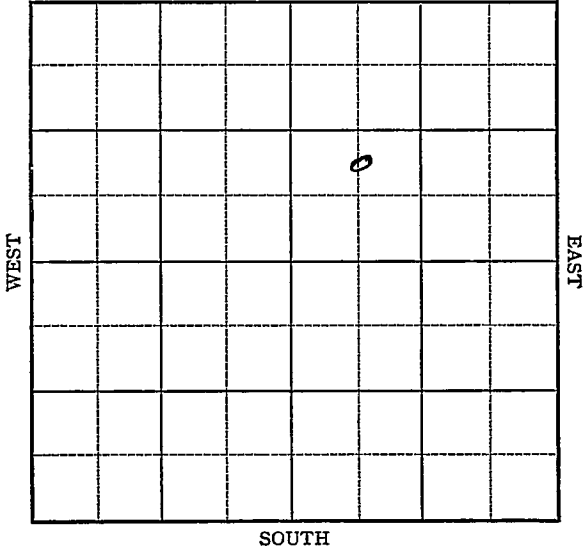

Sec. 28 Twp. 14 R. 13 -W

Well No. #5 Giese Farm

R. H. Shields et al Company
(Hall Gurney)


_____ Ft. from N. Line

990 Ft. from S. Line

_____ Ft. from E. Line

660 Ft. from W. Line

Elev. 1737

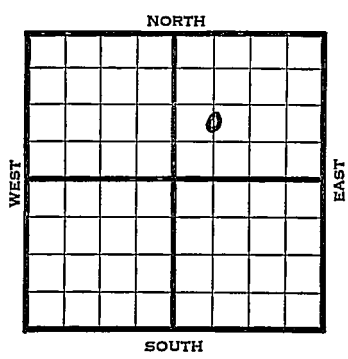

1941	REPORT
4/30	Cable.
5/8	20" - 21' 15" - 1471'
	12" - 365' Drlg. 475'
5/15	Anhy 667' 10" - 680'
	Drlg. 1210'
5/22	Drlg. 2055'
5/28	8" - 2298' Drlg. 2600'
6/5	Lans. 2865' 7" - 2877'
	T.D. 2913' WOC.
6/11	Lans. 2865'
	7" - 2877'
	T.D. 2913'
	8000 acid.
	Pump 892 oil plus 22 water
	37.8 Gravity
	COMPLETED

Map No. 72 Sec. 28 Twp. 14 R. 13W

Well No. 5 Giese

R. H. Shields etal Company

Contractor

FIRST REPORT

C N L SW NE

_____ Ft. from N. Line

990 Ft. from S. Line

_____ Ft. from E. Line

660 Ft. from W. Line

HALL GURNEY POOL

SECTION PLAT

		o	

Location _____

Rig up _____

Drilling and Remarks:

Cable

RECORD

Cased _____ in., _____ ft.

Sand _____

Gas _____

Oil _____

Total Depth _____

PRODUCTION

1st 24 hrs. Nat. _____

1st 24 hrs. after shot _____

Gas _____ Cu. Ft.

Dry Hole _____

Abandoned _____

Date

APR 30 1941 19

S. J. LEWIS Scout

