


Section 5 Township 33 Range 4 E

Well No. # 1 Husted

Company Texas Company

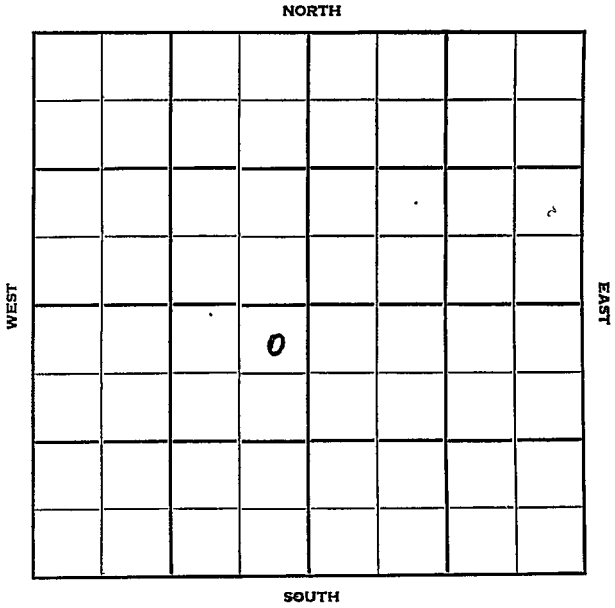

Sec. 5 Twp. 33 R. 1E

Well No. #1 Husted Farm

Texas Company Company


Laura Jane Contractor

330 Ft. from N. Line

_____ Ft. from S. Line

330 Ft. from E. Line

_____ Ft. from W. Line

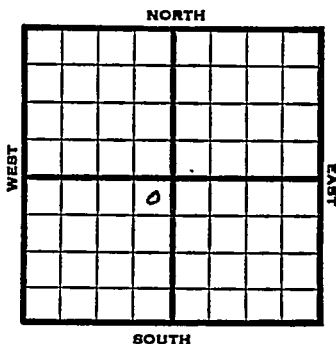

NE NE SW

1953 Elev. 1210' REPORT

6/37 Loc.

7,15 Spud 6-17-53

D & A

TD 3211'

10" @ 264'

Stal. 2130, Layton 2533, KC 2691

DST 1333-64 opn 1½ hr, rec 12' mud,

430#

DST 2725-45 opn 2 hr, rec 90' hocm

705#

DST 2816-23 opn 1½ hr, rec 15' mud,

87# Peru 2837

TD 3211

7" @ 3210'

Bart 3140, Miss 3208

CO to 3195

10/ 3190-93 Hydro. S/ 2½ bo PB 2799

23/ 2763-75 500 A dry CO to

2740

10/ 2734-37 500 A 8 go 13 bswph

S/ 2 go 2 bswph

D & A

ABANDONED

