


Section 28 Township 14 Range 13W

Well No. #11 Giese

Company Sheilds Oil

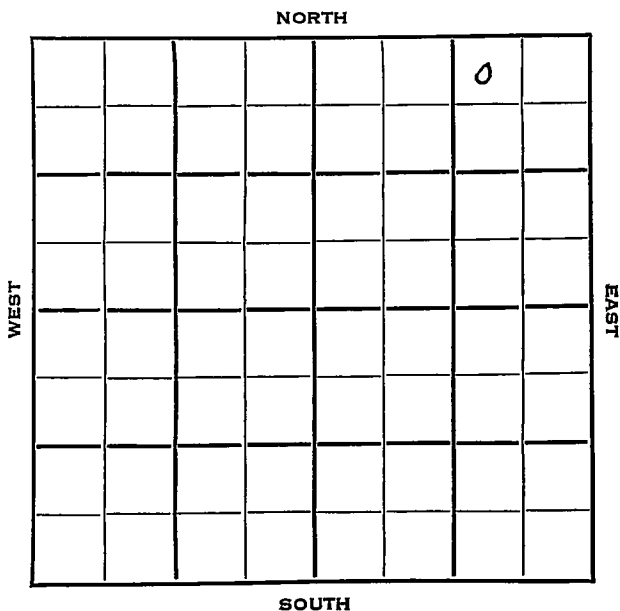

Russell

KANSAS

SEC.	TWP.	R.
28	14	13W ✓

WELL NO.

11 Giese

FARM

COMPANY

Shields Oil

CONTRACTOR

Hall-Gurney Pool

330

Ft. from N. Line


Ft. from S. Line

990

Ft. from E. Line

Ft. from W. Line

NW NE NE

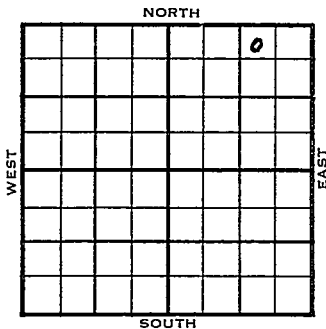

1953

ELEVATION

1752'

REPORT

11/4

Cellar & Pits

11/11
11/18

"

12/16

"

1954

1/6

Drlg. 70'

1/13

15" @ 42'

12" @ 388'

10" @ 699'

Drlg. 1250'

1/20

Drlg. 2120'

2/10

Spud 1-3-54 Oil well TD 2352

15" @ 42 12" @ 388 10" @ 699

8" @ 2220 TD 2352 7" @ 2352

CO to 2300 12/2268-73 sd-oil-frac.

S/5 $\frac{1}{2}$ BOPH

Comp. 25 BOPD

COMPLETED

