


Section 28 Township 14 Range 13W

Well No. 12 Giese

Company Shields Oil

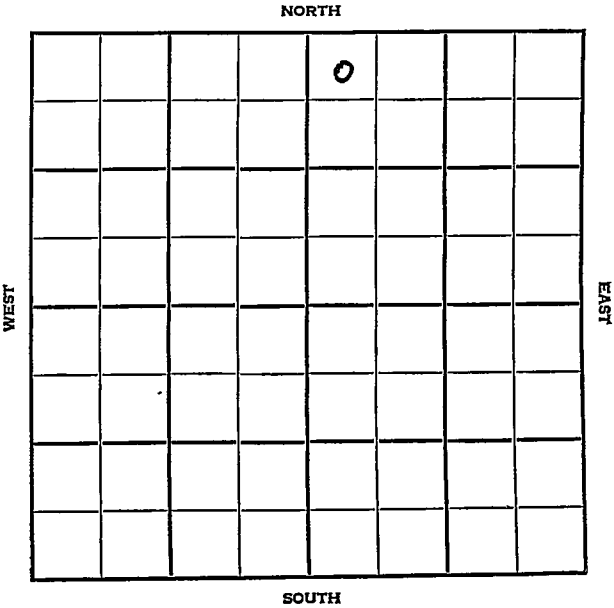

Russell KANSAS

SEC.	TWP.	R.
28	14	13 W

WELL NO. # 12 Giese FARM

COMPANY Shields Oil

CONTRACTOR

Go. tools Hall-Gurney Pool


330 Ft. from N. Line

Ft. from S. Line

Ft. from E. Line

330 Ft. from W. Line

NW NW NE (Twin well)

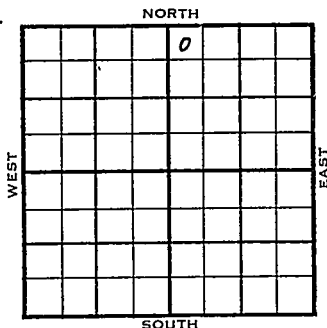

1954	ELEVATION	REPORT
------	-----------	--------

10/20 Spud 10-16-54
15" @ 65'
Drlg. 235'

12/29 Spud 10-16-54
Oil Well
TD 2400'
15" @ 65'
10" @ 693'
Anhy 688' Tarkio 2272'
TD 2400'
5" @ 2400'
CO to 2360 64/ 2270'-2302 S/ 2 1/2 go hydrofrac.
Comp 12 bopd. 3 bw.

COMPLETED

County Russell State Kansas
 Sec. 28 (Blk. Twp.) 14 (Sur. Rge.) 13W Map No. _____
 Operator Shields Oil
 Well No. 12 Farm Giese
 Elev. _____ Location NW NW NE (twin well)

				6			

FIRST REPORT

330 Ft. From N Line NE
 330 Ft. From W Line Quarter
 1st. Report OCT 20 1954
 Completion _____
 Remarks _____
Co. tools
 Spudding Date 10-16-54

Drlg. Data Hall-Gurney Pool
15" @ 65 drlg. 235

FABEN GILSTRAP

County Russell State Kansas
 Sec. 28 (Blk. 14 (Sur. 13W Map No.
 (Twp.) (Rge.)
 Operator Shields Oil
 Well No. 12 Farm Giese
 Elev. Location NW NW NE (twin)

330 Ft. From N Line NE
330 Ft. From W Line Quarter

1st. Report

Completion DEC 29 1954

Remarks Hall-Gurney Pool

Co. tools

Spudding Date 10-16-54

Drlg. Data Oil well TD 2400'

15" @ 65 10" @ 693 Anhy 688

Tarkio 2272 TD 2400 5" @ 2400

CO to 2360 64/ 2270-2302 S/ 2 $\frac{1}{2}$ go

hydrofrac Comp. 12 bopd 3 bw

FABEN GIL STRAP