

KANSAS

Russell


Form 51-5M-7-40-Palace

Section 28 Township 14 Range 13-W

Well No. #5 Graham

Company Cities Service Oil

NORTH Hall Gurney Pool

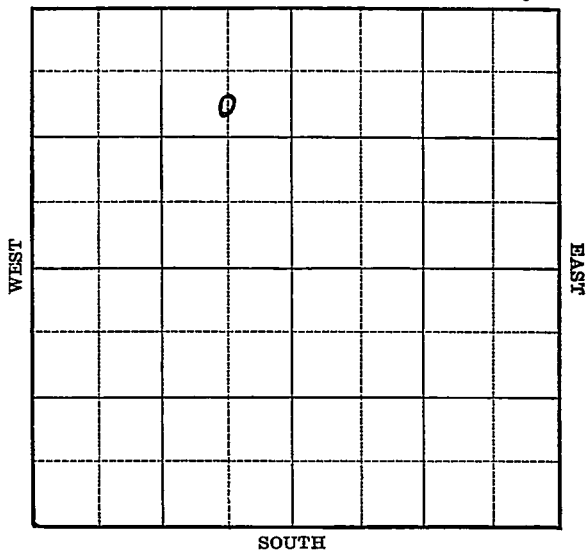

Sec. 28 Twp. 14 R. 13-W

Well No. #5 Graham Farm

Cities Service Oil Company


(Hall Gurney)

990 Ft. from N. Line

_____ Ft. from S. Line

660 Ft. from E. Line

_____ Ft. from W. Line

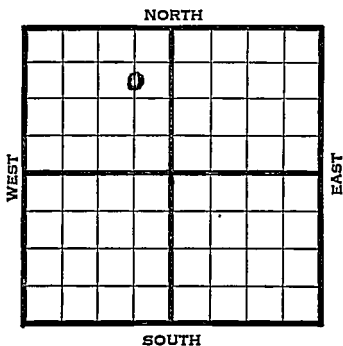

Elev. 1748

1941	REPORT
3/12	Derrick.
3/20	8" - 328' Drlg. 1750'
3/27	Lans. 2884' T.D. 3159' S.O.
	Run csg.
4/2	5" - 3159' T.D. 3170'
	2400' water. Plug back.
4/10	" " " "
	-
4/16	Lansing 2884'
	T.D. 3170'
	4000 acid & 3500 acid.
	Pump 693 oil & 25% water.
	38. Gravity
	COMPLETED

Russell

Map No. 72 Sec. 28 Twp. 14 R. 13WWell No. 5 Graham

Cities Service Oil

Company

Contractor

FIRST REPORT

C S L NE NW

990 Ft. from N. Line Ft. from S. Line660 Ft. from E. Line Ft. from W. Line

HALL GURNEY POOL

SECTION PLAT

	o		

Location Rig up

Drilling and Remarks:

Derrick

RECORD

Cased in., ft.Sand Gas Oil Total Depth

PRODUCTION

1st 24 hrs.-Nat. 1st 24 hrs. after shot Gas Cu. Ft.Dry Hole Abandoned

Date

MAR 12 1941 19S. J. LEWIS Scout

Map No. 72 Sec. 28 Twp. 14 R. 13W

Well No. 5 Graham

Cities Service Oil Company

Contractor

COMPLETED

C S L NE NW

990 Ft. from N. Line

_____ Ft. from S. Line

660 Ft. from E. Line

_____ Ft. from W. Line

HALL GURNEY POOL

SECTION PLAT

	o		

Location _____

Rig up _____

Drilling and Remarks:

*4000 acid +
3500 acid
Pump 693 oil
+ 25% water
38 gpus.*

RECORD

Cased _____ in., _____ ft.

San *casing 2884*

Gas _____

Oil _____

Total Depth ~~3170~~ *3170*

PRODUCTION

1st 24 hrs. Nat. _____

1st 24 hrs. after shot _____

Gas _____ Cu. Ft.

Dry Hole _____

Abandoned _____

Date

APR 16 1941

19

S. J. LEWIS

Scout