


Cowley

KANSAS

SECTION 7 TOWNSHIP 33S RANGE 4E

WELL NO. #1 Fred M. Schul

COMPANY The Texas Co.

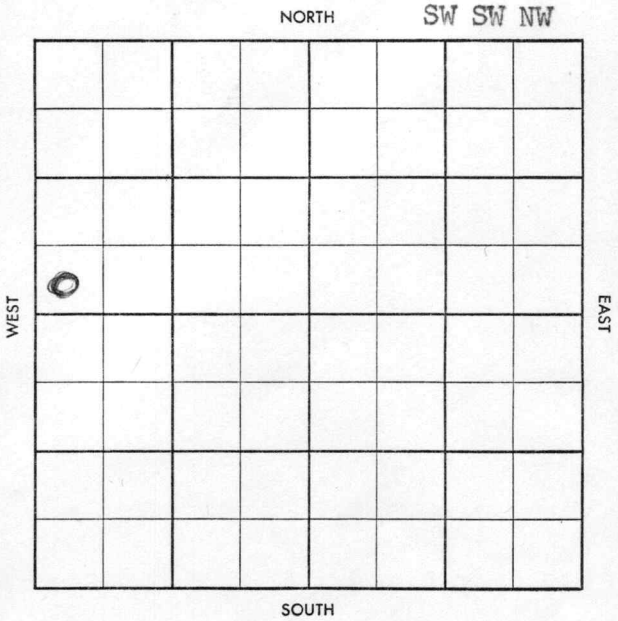

~~Topographic Field Notes~~
~~Geological Field Notes~~

County Cowley Elev. _____
 Sec. 7 Twp. 33 Rge. 4E
 Company The Texas Co.
 Farm Name Fred M. Schul No. 1

TOPS	DEPTH	LOG	DATUM
Anh.			
Tp.			
H.			
Tr.			
Dg.			
B.L.			
L.			
K.C.			
B.K.C.			
Ce.			
C.			
M.			
M.			
K.			
Mz.			
Mq.			
V.			
S.			
S.			
A.			
R.			
Pf.			
G.			
T.D.			

Loc. in Sec. _____

SW SW NW

Geol. _____

Contr. _____

Pool _____

Crane

Date Comm. _____

Location

Co.

Lse.

No.

Sec.

T.

R.

S-513-B

TOPS	DEPTH	LOG	DATUM
Anh. <u>5401</u>	<u>2142</u>		
Tp.			
H.			
Tr.			
Dg.			
B.L.			
L.			
K.C.	<u>2527</u>		
B.K.C.			
Ce. <u>Cottage</u>	<u>2546</u>		
C. <u>Makim</u>	<u>2909</u>		
M. <u>BOSW</u>	<u>3018</u>		
M. <u>BVI</u>	<u>3188</u>		
K. <u>M</u>	<u>3216</u>		
Mz. <u>M Li</u>	<u>3252</u>		
Mq.			
V.			
S.			
S.			
A.			
R.			
Pf.			
G.			
T.D.	<u>3260</u>		

COMPLETE			
0			
JUN 25 '58			

7" 3259 WOC MAY 28 '58 Co 3251
64/ 3230-46 890 39M PH
3 hrs 250A tst 4090 29W
PH from tstg JUN 3 '58 F10 27 B0
15 BW 5 1/2 hrs 20/60" chr JUN 11 '58
~~F10 27 B0 15 B~~ JUN 18 '58 JUN 25 '58 F10
25 B0 35 BW 8 hrs P.F10 106
B0 pd + 4490 W 38°W