

KANSAS

Russell

Form 51-5M-7-40-Palace


Section 28 Township 14 Range 13-W

Well No. #3 Graham

Company Cities Service Oil

Hall Pool

NORTH

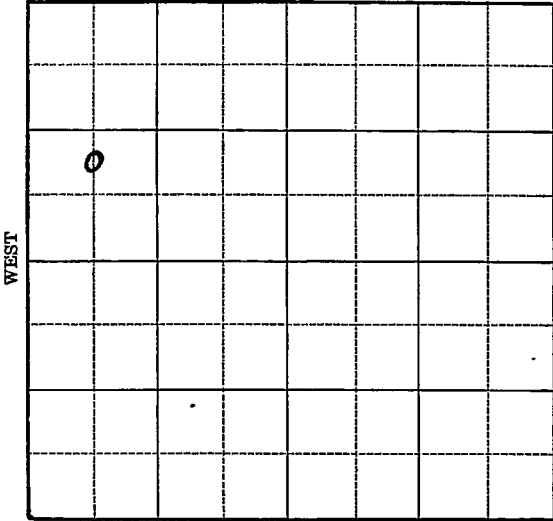

WEST

EAST

SOUTH

Map No. 72 Sec. 28 Twp. 14 R. 13WWell No. 3 GrahamCities Service Oil Company

Contractor

FIRST REPORT

C N L SW NW

_____ Ft. from N. Line

990 Ft. from S. Line

_____ Ft. from E. Line

660 Ft. from W. Line

HALL POOL

SECTION PLAT

o			

Location _____

Rig up _____

Drilling and Remarks:

Drlg., 2001

RECORD

Cased _____ in., _____ ft.

Sand _____

Gas _____

Oil _____

Total Depth _____

PRODUCTION

1st 24 hrs. Nat. _____

1st 24 hrs. after shot _____

Gas _____ Cu. Ft.

Dry Hole _____

Abandoned _____

Date

SEP 25 1940 19S. J. LEWIS Scout

Map No. 72 Sec. 28 Twp. 14 R. 13WWell No. 3 GrahamCities Service Oil

Company

Contractor

COMPLETED

C N L SW NW

SECTION PLAT

0			

_____ Ft. from N. Line

990 Ft. from S. Line

_____ Ft. from E. Line

660 Ft. from W. Line

HALL POOL

Location _____

Rig up _____

Drilling and Remarks:

*See lam 8164**5" C 8164**Lans 2880**14 4 Blk to 2880-2975**5000 acid**Pump. 718 P.D.***RECORD**

Cased _____ in., _____ ft.

Sand _____

Gas _____

Oil _____

Total Depth 8164**PRODUCTION**

1st 24 hrs. Nat. _____

1st 24 hrs. after shot _____

Gas _____ Cu. Ft.

Dry Hole _____

Abandoned _____

Date

OCT 16 1940S. J. LEWIS Scout