

(WH7-DC25)✓

Cowley

KANSAS

SECTION 7 TOWNSHIP 33S RANGE 4E

WELL NO. #1-Crane

COMPANY Wrico Drlg.

NW SW SW

NORTH

WEST

EAST

0							

SOUTH


SEC. 7 TWP. 33 S R. 4 E

WELL NO. #1 Crane FARM

COMPANY Wrico Drlg. Co.

CONTRACTOR Co. tools Wildcat

\_\_\_\_\_ FT. FROM N. LINE  
 \_\_\_\_\_ FT. FROM S. LINE  
 \_\_\_\_\_ FT. FROM E. LINE  
 \_\_\_\_\_ FT. FROM W. LINE

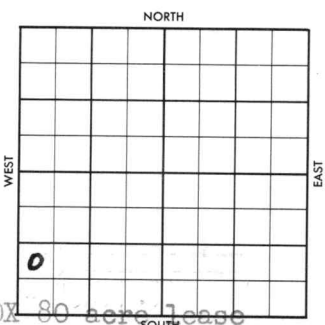

NW SW SW  
 Direct South Offset to SDX 80 acre lease  
 (S-21513, S-21496) SDX-DHC-\$2,500.00

1957 ELEVATION 1175' REPORT (WH7-DC25) ✓

Miss. Test appx 3250'

3/6 To be commenced by April 3, 1957  
 To be completed by May 3, 1957  
 (See copy DHG Agt. 3-6-57)

4/23 SDX GRANTS TIME EXTENSION AS FOLLOWS:  
 To be commenced by July 10, 1957  
 To be completed by August 1, 1957  
 (See letter of extension 4-18-57)

7/10 Location (FR Tkt)

10/30 Spud 7-24-57  
 8-5/8" @ 100  
 Stal 2156', Lay 2570', KC 2752'  
 Osw 2934', Ce Sh 3048', M. Chert 3248'  
 DST 3252-65, open 90", 1600' gas, rec  
 90' HOCM & show free oil. FP 15-50#  
 BHP 812# 30". RTD 3300' To run pipe  
 @3300'. 5 1/2" @ 3300 Perf 40/3252-60  
 FU 240' oil + 100' wtr 12 hrs. Frac?  
 FU 400' oil + 600' wtr. Re-frac  
 sd-wtr. S/2 BOPH + 8 BWPH 12 hrs. POP  
 (need SWD well. Want to pump for 30 das  
 P/50 BO + 240 BW 24 hrs. (pump awhile)  
 P/26 1/2 BO + 40 BW 24 hrs. Grav 36.  
 P/16 BO + 32 BW 24 hrs. Testing.  
 P/18 BO 10 BWPD. Miss 3252-60' TD 3300'  
 (Sonut Comp. Ticket) **COMPLETED** ✓

# WILDCAT

FORM 513 SUNRAY

County Cowley Elev. \_\_\_\_\_  
 Sec. 7 Twp. 38 Rge. 4E  
 Company Wrico Drlg.  
 Farm Name Crane No. 1

TOPS	DEPTH	LOG	DATUM	Loc. in Sec.
Anh.				NW SW SW
Tp.				
H.				
Tr.				
Dg.				
Bl.				
L.				Geol. _____
K.C.				Contr. _____
B.K.C.				
Ce.				Co. tools
C.				Pool
M.				Wildcat
M.				
K.				
Mz.				
Ma.				
V.				
S.				
S.				
A.				
R.				
Pe.				
G.				
T.D.				

FIRST REPORT  
 JUL 10 57

Date Comm. SDX-DHM

Location \_\_\_\_\_

~~29~~

728 5 2 1957  
M.M.

Co.  
Lse.  
No.  
Sec.  
T.  
R.

County Cowley Elev. 1175 Co.  
 Sec. 7 Twp. (33) Rge. 1E  
 Company Wrico Drlg.  
 Farm Name Crane No. 1

TOPS	DEPTH	LOG	DATUM	Loc. in Sec.
Anh. <u>stala.</u>	<u>2156</u>			NW SW SW
Tp. <u>Lay</u>	<u>2570</u>			
H.				
Tr.				
Dg.				
Bl.				
L.				
K.C.	<u>2252</u>			Geol.
B.K.C. <u>osw</u>	<u>2934</u>			Contr.
Ce. <u>sh</u>	<u>3048</u>			Co. tools
C.				
M. <u>chert</u>	<u>3248</u>			Pool
M. <u>L1</u>	<u>3270</u>			<u>Wildcat</u>
K.				<div style="border: 1px dashed black; padding: 5px; text-align: center;">                 COMPLETE                  OCT 30 '57             </div>
Mz.				
Mq.				
V.				
S.				
S.				
A.				
R.				
PE.				
G.				
TD.	<u>3300</u>			

Date Comm.

Location JUL 17 '57 7-24-57  
878 100 D 1885 JUL 24 '57 stala 2156  
Lay 2570 KC 2752 osw 2934  
Ce sh 3048 M. chert 3248 DST  
3252-65 up 90" 1600' 925 rec 90'  
HOCM + show Free oil FP 15-50  
BHP 812 / 30" RTP 3300 To run  
pipe @ 3300 JUL 31 '57 5 1/2 @ 3300 40'  
3252-60 1/4 FU 240' oil + 100' wts 12 lbs  
frac? FU 900' oil + 600' wts AUG 8 '57

~~Re~~ Refrac sd-wtr \$ 2 Bophs  
+ 8 Bwph 12 hrs pop.

(needs wd well want to pump  
for 30 days) ~~NOV 14 '57~~ P. 50

B0 + 240 BW 24 hrs (To pump  
2 while) ~~AUG 21 '57~~ ~~AUG 28 '57~~ P. 26 1/2 B0

+ 40 BW 24 hrs gravi. 36° ~~SEP 4 '57~~

~~SEP 11 '57~~

Log tops same PUMP

16 B0 + 32 BW 24 hrs testing

~~SEP 18 '57~~

~~SEP 25 '57~~

~~OCT 2 '57~~

~~OCT 9 '57~~

~~OCT 18 '57~~

~~Oct 23 '57~~

~~OCT 30 '57~~

P 18 B0 10 BW pd

Miss 3252-60