

KANSAS

Russell

FORM 51 25M 3-49 PETROL


Section 28 Township 14 Range 13W

Well No. 7 Graham

Company Cities Service

Hall-Gurney

NORTH

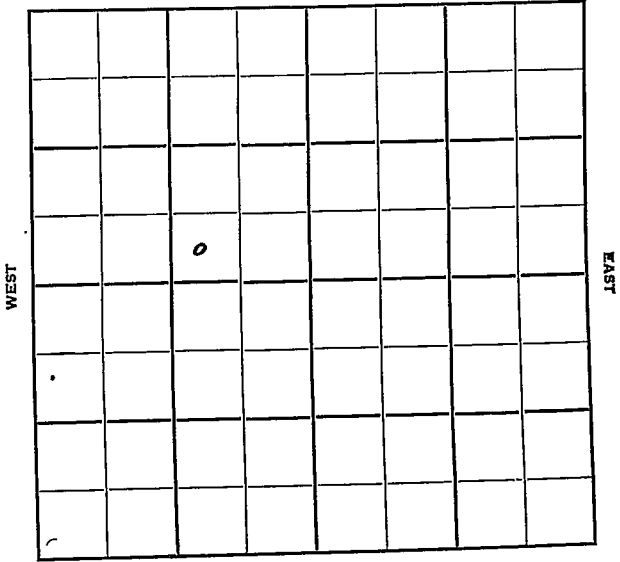


SOUTH

Sec. 28 Twp. 14 R. 13W ✓

Well No. #7 Graham Farm
Cities Service Company

Hall-Gurney Pool

_____ Ft. from N. Line
330' Ft. from S. Line
990' Ft. from E. Line
 _____ Ft. from W. Line

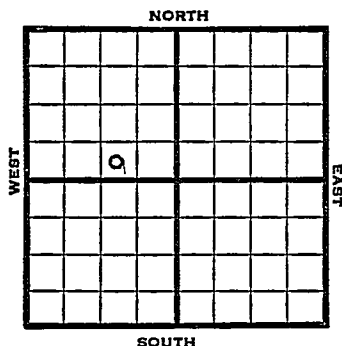

SW SE NW

1949 Elev 1743' REPORT

4/13 Location
 4/20 8" @ 190
 Drlg 1873'
 4/27 Drlg 3045'
 5/4 Lansing 2873'
 Gorham 3157-58'
 TD 3158'
 5" @ 3158'
 5/10 "
 5/18 Lans 2873'
 Gorham 3157'
 5" @ 3158'
 Perf Lans/
 4000 acid
 Pump 165 oil / 35 W Pot
 40^g Gr.
 Comp

COMPLETED

Map No. _____ Sec. 28 Twp. 14 R. 13W

Well No. 7 Graham

Cities Service Company

FIRST REPORT

Contractor

SW SE NW

SECTION PLAT

_____ Ft. from N. Line

330 Ft. from S. Line

990 Ft. from E. Line

_____ Ft. from W. Line

Russell County

Location X

Rig up _____

Drilling and Remarks:

RECORD

Cased _____ in., _____ ft.

Sand _____

Gas _____

Oil _____

Total Depth _____

PRODUCTION

1st 24 hrs. Nat. _____

1st 24 hrs. after shot _____

Gas _____ Cu. Ft.

Dry Hole _____

Abandoned _____

Date

APR 13 1949

S. J. LEWIS

Scout

Map No. K72 Sec. 28 Twp. 14 R. 13W

Well No. 7 Graham

Cities Service Company

COMPLETE

Contractor

SW SE NW

E11743
SECTION PLAT

_____ Ft. from N. Line

330 Ft. from S. Line

990 Ft. from E. Line

_____ Ft. from W. Line

Russell County

Location _____

Rig up _____

Drilling and Remarks:

Lane 2823
302 km 3157
5' @ 3157
Prof Lane
Hooan
Pump 165 oil 735N
Box

RECORD

Cased _____ in., _____ ft.

Sand _____

Gas _____

Oil _____

Total Depth 2160

PRODUCTION

1st 24 hrs. Nat. _____

1st 24 hrs. after shot _____

Gas _____ Cu. Ft.

Dry Hole _____

Abandoned _____

Date

40 5/29

MAY 18 1949

S. J. LEWIS Scout