


Section 27 Township 14 Range 13W

Well No. 3-A Rein

Company Jones & Shelborne

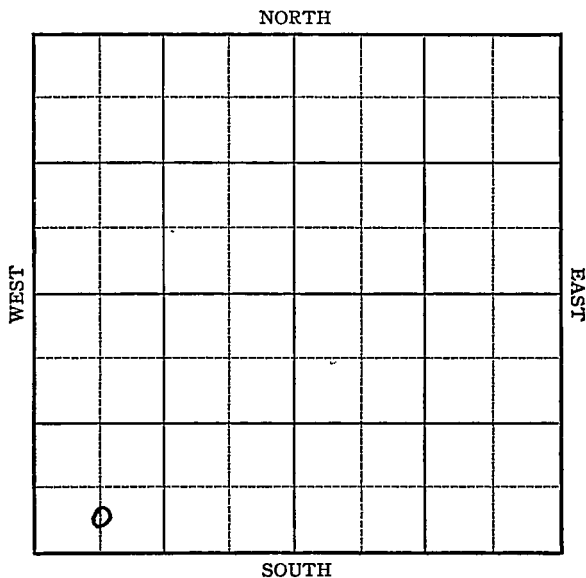

Sec. 27 Twp. 14 R. 13-W

Well No. #3-A Rein Farm

Jones & Shelborne Company

(Hall Gurney)


_____ Ft. from N. Line

330 Ft. from S. Line

_____ Ft. from E. Line

660 Ft. from W. Line

Elev. 1708

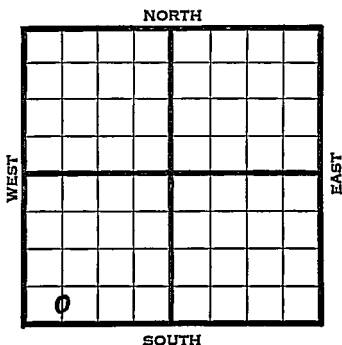

1941	REPORT
6/11	Cellar.
6/19	Cable rig.
6/26	" "
7/3	Rigging up.
7/10	15½" - 130' 13" - 325'
	Anhy 620' Drlg. 650'
7/17	S/Gas 1570-75' Drlg. 1820'
7/24	8" @ 2500 Topkeka 2525 Drlg. 2570
7/31	Lans. 2838 TD 2876' SD
	7" @ 2870 WOC.
8/7	TD 2881 8000 acid.
8/13	Lans. 2838'
	7" - 2870'
	8100 acid.
	T.D. 2881
	Pump 292 oil 8 hrs
	Pmp pot. 876'
	Grav. 38.3
	COMPLETED

Map No. 72 Sec. 27 Twp. 14 R. 13WWell No. 3-A ReinJones & Shelborne Company

Contractor

FIRST REPORT

C S L SW SW

 Ft. from N. Line330 Ft. from S. Line Ft. from E. Line660 Ft. from W. Line

HALL GURNEY POOL

SECTION PLAT

Location Rig up

Drilling and Remarks:

Cellar : .

RECORDCased in., ft.Sand Gas Oil Total Depth **PRODUCTION**1st 24 hrs. Nat. 1st 24 hrs. after shot Gas Cu. Ft.Dry Hole Abandoned

Date

JUN 11 1941
19S. J. LEWIS Scout

Map No. 72 Sec. 27 Twp. 14 R. 13W

 Well No. 3-A Rein
Jones & Shelborne Company

Contractor

SECTION PLAT

C S L SW SW

_____ Ft. from N. Line

330 Ft. from S. Line

_____ Ft. from E. Line

660 Ft. from W. Line

HALL GURNEY POOL

Location _____

Rig up _____

Drilling and Remarks:

Lans 2838
7" 2870
8900 acid
Pump 292 oil 5 hrs
Pump 876
COMPLETED

RECORD

Cased _____ in., _____ ft.

Sand _____

Gas _____

Oil _____

 Total Depth 2881

PRODUCTION

1st 24 hrs. Nat. _____

1st 24 hrs. after shot _____

Gas _____ Cu. Ft.

Dry Hole _____

Abandoned _____

Date

AUG 13 1941
383 gas

19

S. J. LEWIS Scout