

# KANSAS

Form 51-5M-7-40-Palace


Russell

Section 27 Township 14 Range 13-W

Well No. 2-A Rein

Company Jones & Shelborne

NORTH Hall Gurney Lans. Pool

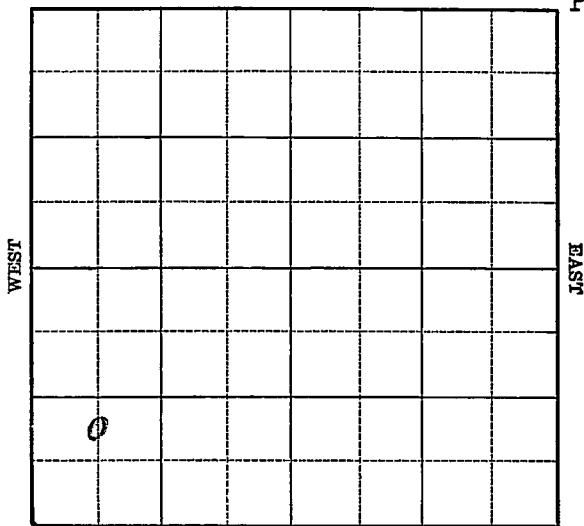

SOUTH

Sec. 27 Twp. 14 R. 13-W

Well No. #2-A Rein Farm

Jones & Shelborne Company

(Hall Gurney Lans)


\_\_\_\_\_ Ft. from N. Line

990 Ft. from S. Line

\_\_\_\_\_ Ft. from E. Line

660 Ft. from W. Line

Elev. 1711

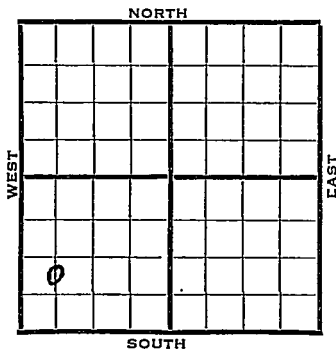

1941	REPORT
1/15	Material.
1/23	"
1/30	"
2/6	Cable rig.
2/13	Spud 150'
2/20	13" - 323' Anhy 627'
	10" - 635' Drlg. 1040'
2/27	Drlg. 1915'
3/6	8" - 2205' Show gas 2210-15'
	Drlg. 2404'
3/13	Lans. 2856' . 7" - 2863'
	T.D. 2870' S.O.
3/19	Lans. 2856'
	7" - 2863'
	T.D. 2887'
	80.00 acid.
	Potential 3393 bbls., pump.
	38.3 Gravity
	<b>COMPLETED</b>

Map No. 72 Sec. 27 Twp. 14 R. 13WWell No. 2-A ReinJones & Shelborne

Company

Contractor

**FIRST REPORT****SECTION PLAT**

C N L SW SW

\_\_\_\_\_ Ft. from N. Line

990 Ft. from S. Line

\_\_\_\_\_ Ft. from E. Line

660 Ft. from W. Line


HALL GURNEY Land Pool

Location \_\_\_\_\_

Rig up \_\_\_\_\_

Drilling and Remarks:

Material

**RECORD**

Cased \_\_\_\_\_ in., \_\_\_\_\_ ft.

Sand \_\_\_\_\_

Gas \_\_\_\_\_

Oil \_\_\_\_\_

Total Depth \_\_\_\_\_

**PRODUCTION**

1st 24 hrs. Nat. \_\_\_\_\_

1st 24 hrs. after shot \_\_\_\_\_

Gas \_\_\_\_\_ Cu. Ft.

Dry Hole \_\_\_\_\_

Abandoned \_\_\_\_\_

Date

JAN 15 1941S. J. LEWIS Scout

Map No. 72 Sec. 27 Twp. 14 R. 13W

Well No. 2-A Rein

Jones & Shelborne

Company

Contractor

**COMPLETED**

C N L SW SW

**SECTION PLAT**

o			

\_\_\_\_\_ Ft. from N. Line

990 Ft. from S. Line

\_\_\_\_\_ Ft. from E. Line

660 Ft. from W. Line

HALL GURNEY LANS. POOL.

Location \_\_\_\_\_

Rig up \_\_\_\_\_

Drilling and Remarks:

*Lans 2856  
7" @ 2863  
5000 acid  
Pump 3393 P.D.  
383 3/4*

**RECORD**

Cased \_\_\_\_\_ in., \_\_\_\_\_ ft.

Sand \_\_\_\_\_

Gas \_\_\_\_\_

Oil \_\_\_\_\_

Total Depth 2887

**PRODUCTION**

1st, 24 hrs. Nat. \_\_\_\_\_

1st 24 hrs. after shot \_\_\_\_\_

Gas \_\_\_\_\_ Cu. Ft.

Dry Hole \_\_\_\_\_

Abandoned \_\_\_\_\_

Date

MAR 17 1941 19

S. J. LEWIS

Scout