

Section 27 Township 14 Range 13 W

Well No. # 1 Fee

Company Allie Rogg

NORTH

						0	

WEST

EAST

SOUTH

Russell

KANSAS

Sec. 27 Twp. 14 R. 13 W

Well No. # 1 Fee Farm

Allie Rogg Company

Shields Contractor

Hall-Gurney Pool NORTH


Ft. from N. Line

990 Ft. from S. Line

990 Ft. from E. Line

Ft. from W. Line

NW SE NE

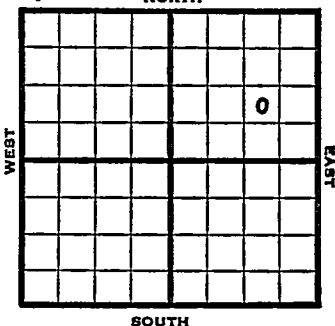

1953 Elev. 1697' REPORT

6/17 MICT

6/24 15" @ 39 13" @ 305

Drlg. 490'

Drlg. 1330'

7/1

7/8 Anhy 630'

10" @ 635'

Drlg 2205'

7/15

Spud 6-18-53 D & A TD 2321'

15" @ 39 13" @ 305 Anhy 630

10" @ 635 Tarkio 2295 TD 2321

VSSO & wtr.

D & A

ABANDONED

