


Section 27 Township 14 Range 13-W

Well No. #4 Rein "A"

Company Continental

NORTH Hall Pool

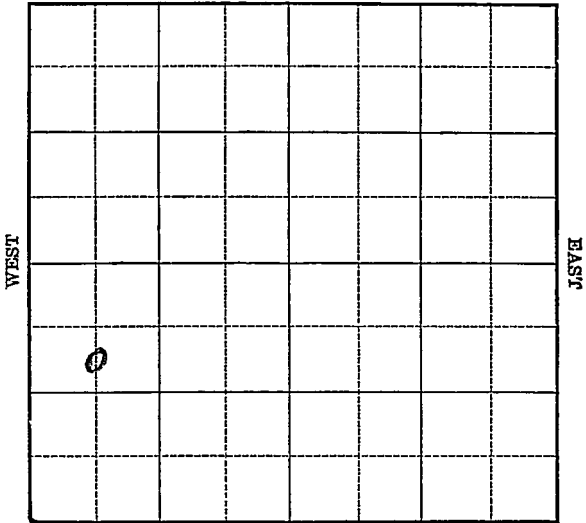

SOUTH

Sec. 27 Twp. 14 R. 13-W

Well No. #4 Rein "A" Farm _____

Continental Company


(Hal 1)

990 Ft. from N. Line

_____ Ft. from S. Line

_____ Ft. from E. Line

660 Ft. from W. Line

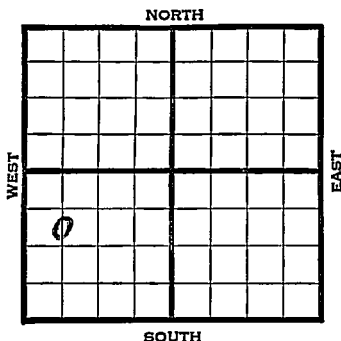

Elev. 1738

1940	REPORT
10/9	S. H.
10/17	10" - 382' Dr lg. 2848'
10/24	Lans. 2860' 6" - 2890'
	T.D. 2915' 900' oil. 7000 acid.
10/30	Lans. 2860'
	6" - 2890'
	T.D. 2915'
	8000 acid.
	Potential 891 bbls., P & F.
	COMPLETED

Map No. 72 Sec. 27 Twp. 14 R. 13WWell No. 4 Rein "A"Continental Company

Contractor

COMPLETED

C S L NW SW

990 Ft. from N. Line

_____ Ft. from S. Line

_____ Ft. from E. Line

660 Ft. from W. Line**SECTION PLAT**

HALL POOL

Location _____

Rig up _____

Drilling and Remarks:

*Line 2860**6" @ 2890**5000 acid**P&F 891 P.D.***RECORD**

Cased _____ in., _____ ft.

Sand _____

Gas _____

Oil _____

Total Depth 2915**PRODUCTION**

1st 24 hrs. Nat. _____

1st 24 hrs. after shot _____

Gas _____ Cu. Ft.

Dry Hole _____

Abandoned _____

Date

OCT 30 1940 19S. J. LEWIS Scout