


Section 27 Township 14 Range 13-W

Well No. 4 Letsch

Company Shileds et al

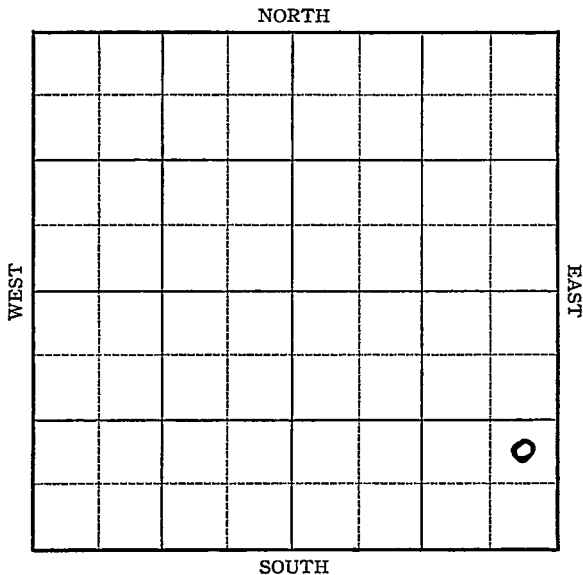

Sec. 27 Twp. 14 R. 13-7

Well No. #4 Letsch Farm

Shields et al Company


 Ft. from N. Line

990 Ft. from S. Line

330 Ft. from E. Line

 Ft. from W. Line

Elev. 1692

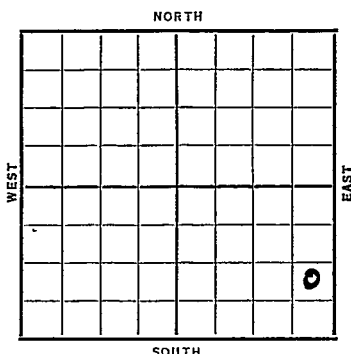

Date	REPORT
1937	
12/1	B.O.R.
12/10	R. U.
12/17	12" @ 238'. Drlg. 350'.
12/24	10" @ 625'. Drlg. 915'.
12/31	Drlg. 2000'.
1938	
1/7	S.G. 1545'. Increase 1720-25 & 1875'. 8" @ 2230'. Est. 3 M gas 2270-75'. Drlg. 2315'.
1/14	Drlg. 2615'.
1/20	K.C. 2809' T.D. 2827' 1300' oil 7" 2823 WOC
1/28	T.D. 2859', 2100' oil - 2 hrs. 10,000 ^{10,000 ACID} made small flow & rig caught fire & burned.
2/4	" " " " "
2/11	Potential 2750 bbls. Will retest.
	OVER

1938

2/16

7" @ 2823'.

K.C. 2809'.

T.D. 2859'.

10,000 acid.

Pump & flow 818.74 bbls. 4 hrs.

and 757 bbls. 4 hrs.

Potential 4543 bbls.

Reported to have perforated
pipe in gas zone & also used
casing pump.

COMPLETED

Russell. **KANSAS**

Map No. _____ Sec. 27 Twp. 14 R. 13W

Well No. 4 Letsch

Shields etal Company

Contractor

COMPLETED
NE SE SE

SECTION PLAT

_____ Ft. from N. Line

			0

990 Ft. from S. Line

330 Ft. from E. Line

_____ Ft. from W. Line

Location _____

RECORD

Rig up _____

Cased 7 in., 2823ft.

Drilling and Remarks:

Sand KC 2809

Gas _____

Oil _____

Total Depth 2859

PRODUCTION

1st 24 hrs. Nat. _____

1st 24 hrs. after shot _____

Gas _____ Cu. Ft.

Date

Dry Hole in

Abandoned Casing pump

FEB 16 1938 19

H. D. Hatfield

Scout

10,000 and
POT - Pump & Flow
818, 74/4 & 757/4
POT 4543
Reported to have perforated gas zone & also used