


SECTION 5 TOWNSHIP 16 RANGE 1W

WELL NO. #2 Hesh

COMPANY Tass Williams

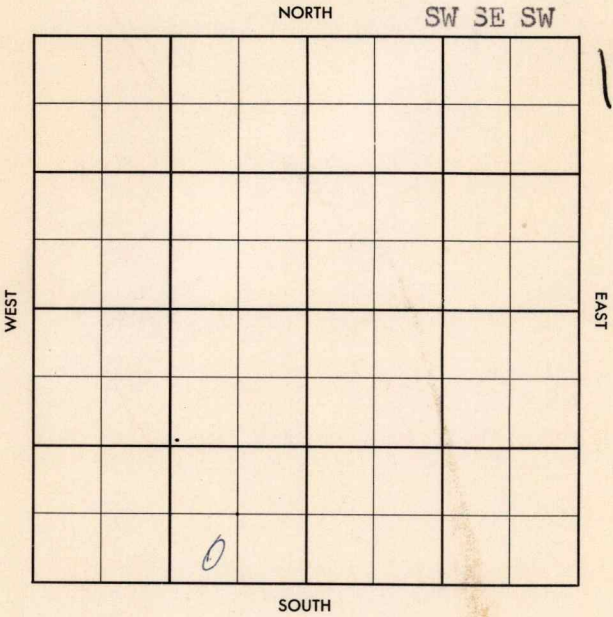

CORRECTION

FORM 513 SUNRAY

Co.

County Saline

Elev.

Sec. 5

Twp. 16

Rge. 1W

Company Tass Williams

Farm Name Hesher

No. 22

TOPS	DEPTH	LOG	DATUM	Loc. in Sec.
Anh.				SW SE SW
Tr.				
H.				
Tr.				
Dg.				
Bl.				
L.				Geol.
K.C.				Contr.
B.K.C.				Greenland Tls
Ce.				
C.				Pool
M.	2654			Hunter No.
M.				
K.				
Mz.				
Mo.				
V.				
S.				
S.				
A.				
R.				
PE.				
G.				
TD.	2672			

L. Sec.

No.

Sec.

T.

R.

Date Comm.

MIRT MAY 1 57 4-25-57 8078 158

1125 5 1/2 2672/50 MAY 8 57 MAY 15 57

DD ~~2778~~ 2686 & 3 Bopd 1 1/2

P. 18 Bopd + 50 Bwpd.

