


Section 35 Township 14 Range 13W

Well No. #5, A.C. Rogg

Company Continental

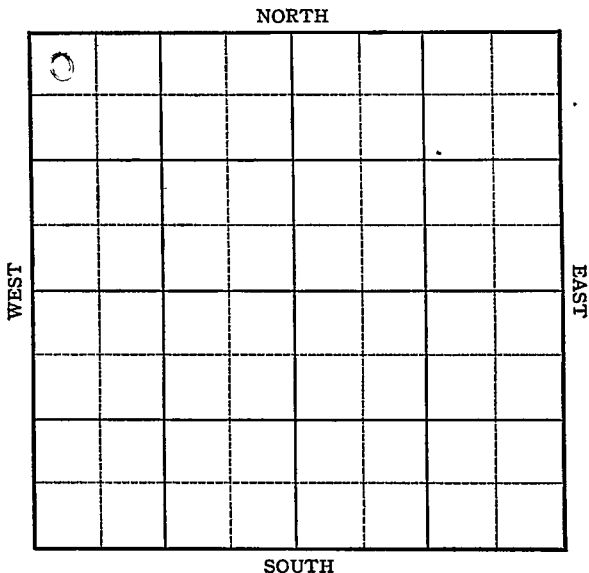

Sec. 35 Twp. 14 R. 13W

Well No. #5 A. C. Rogg Farm \_\_\_\_\_

Continental Company

Hall-Gurney


330 Ft. from N. Line

\_\_\_\_\_ Ft. from S. Line

\_\_\_\_\_ Ft. from E. Line

330 Ft. from W. Line

NW/c

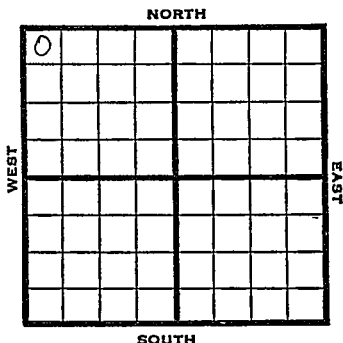

1946 Elev. 1693 REPORT

3/27 Location

4/4 RUR

4/10 10" @ 320; Drlg 630

4/16 Drlg 2576

4/23 Lans 2870  
TD 2938  
7" @ 2937 RUST

5/1 PB 2932  
84 shots 2890-2931  
3000 acid

5/7 63 shots 2839-69  
20 shots 2820-33  
6 shots 2876-82 5000 acid  
Pump 197 oil 49 W in 24 hrs.

5/14 Pump 78 oil 52 W in 24 hrs

5/22 Lans 2810  
7" @ 2937  
TD 2938'  
Perf. Lans. 5000 acid.  
Pump 187 oil plus 54 W. Pot.  
Grav. 39.0

COMPLETED

KANSAS Kansas Pool Name Hall-GurneyMap No. 72 Sec. 35 Twp. 14 R. 13W.Well No. 5 A. C. RoggContinental Company

## FIRST REPORT

Contractor

NW/c

## SECTION PLAT

330 Ft. from N. Line

\_\_\_\_\_ Ft. from S. Line

\_\_\_\_\_ Ft. from E. Line

330 Ft. from W. Line

0			

Russell County

Location X

Rig up \_\_\_\_\_

Drilling and Remarks;

## RECORD

Cased \_\_\_\_\_ in., \_\_\_\_\_ ft.

Sand \_\_\_\_\_

Gas \_\_\_\_\_

Oil \_\_\_\_\_

Total Depth \_\_\_\_\_

## PRODUCTION

1st 24 hrs. Nat. \_\_\_\_\_

1st 24 hrs. after shot \_\_\_\_\_

Gas \_\_\_\_\_ Cu. Ft.

Dry Hole \_\_\_\_\_

Abandoned \_\_\_\_\_

Date

MAR 27 1946 19S. J. LEWIS Scout

**KANSAS** Kansas Pool Name Hall-Gurney

Map No. 72 Sec. 36 Twp. 14 R. 13W

Well No. 5 A. C. Rogg

Continental Company

**COMPLETED**

Contractor

NW/C

*E11693*  
SECTION PLAT

330 Ft. from N. Line

\_\_\_\_\_ Ft. from S. Line

\_\_\_\_\_ Ft. from E. Line

330 Ft. from W. Line

0			

Russell County

Location \_\_\_\_\_

Rig up \_\_\_\_\_

Drilling and Remarks:

*Lans 2810*  
*7" @ 2932*  
*Perf Lans.*  
*5000 cu ft*  
*Pump 187 oil + 54W*  
*P.S.*  
*39° Sw*

**RECORD**

Cased \_\_\_\_\_ in., \_\_\_\_\_ ft.

Sand \_\_\_\_\_

Gas \_\_\_\_\_

Oil \_\_\_\_\_

Total Depth 2938

**PRODUCTION**

1st 24 hrs. Nat. \_\_\_\_\_

1st 24 hrs. after shot \_\_\_\_\_

Gas \_\_\_\_\_ Cu. Ft.

Dry Hole \_\_\_\_\_

Abandoned \_\_\_\_\_

Date

MAY 22 1946 19

S. J. LEWIS Scout