


Seline

KANSAS

SECTION 8 TOWNSHIP 16 RANGE 1W

WELL NO. #2 North Henne

COMPANY T.S. Williams

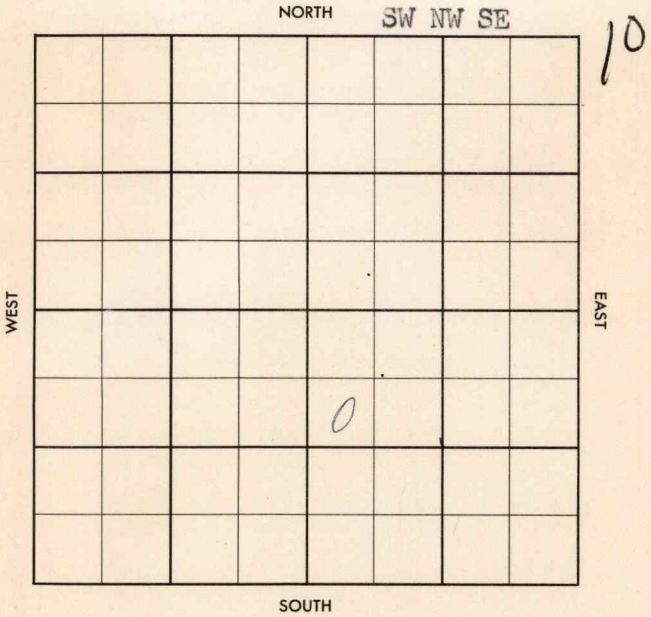

County Saline Elev. 1325
 Sec. 8 Twp. 16 Rgn. 1W
 Company T. S. Williams
 Farm Name North Henne No. 2

TOPS	DEPTH	LOG	DATUM
Anh.			
Tp.			
H.			
Tr.			
Dg.			
Bl.			
L.			
K.C.			
B.X.C.			
Ce.			
C.			
M.	<u>2661</u>	<u>2689</u>	
M.			
K.			
Mz.			
Me.			
V.			
S.			
S.			
A.			
R.			
PE.			
G.			
T.D.	<u>2691</u>		

Loc. in Sec. SW NW SE
 Geol. _____
 Contr. Greenland Tl
 Pool _____
 Hunter No. _____

COMPLETE



Date Comm. _____

Location APR 10 57 APR 17 57 ✓ APR 24 57

4-17-57 8578 159 1125

5/2 2681/50 MAY 1 57 WOCT DAY 8 57

MAY 15 57 OD 2700 TD R \$ 20

Bo + 15 BW pd P. 15 Bopd
+ 50 BW pd.

Co.
 No.
 Sec.
 T.
 R.