


Section 27 Township 14 Range 13-W

Well No. 6 Letsch

Company R. H. Shields

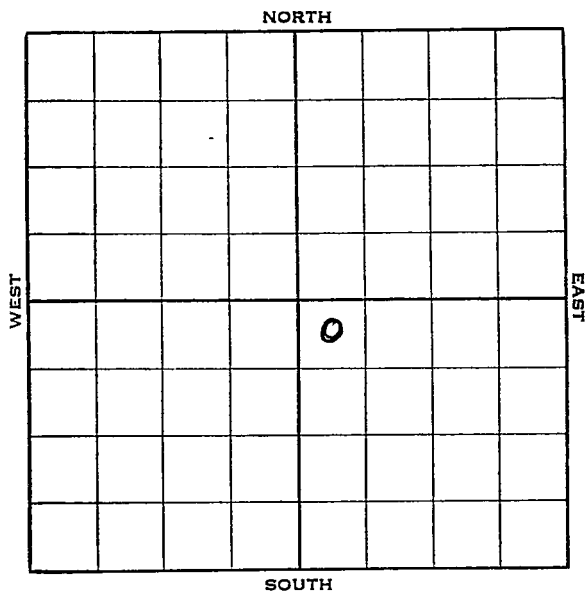

Sec. 27 Twp. 14 R. 13-W


Well No. #6 Letsch Farm
R. H. Shields Company

330 Ft. from N. Line

_____ Ft. from S. Line

_____ Ft. from E. Line

330 Ft. from W. Line

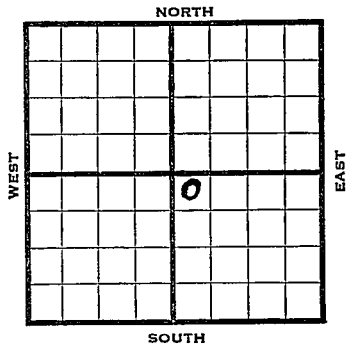

Elev. 1742

1938	REPORT
8/24	RUCT.
9/2	15" - 122'. Drlg. 260'.
9/9	12" - 367'. 10" - 674'. Anh. 620'. Dlg. 965'.
9/16	Drlg. 1920'.
9/23	S. G. 2215-20'. Est. 1/4 M gas. 8" - 2220'. T.D. 2280'. SD for repairs.
9/30	Fsg. 2550'.
10/7	8" - 2550'. Lans. 2845'. Dlg. 2860'.
10/12	5" - 2883'. S. O. 2890'. T. D. 2904'. 2400' oil. 9000 acid. Swabbing.
10/19	5" - 2883'. Lans. 2845'. T. D. 2904'. 18,000 acid (Total) Potential 1808 bbIs.
	COMPLETED

Map No. 72 Sec. 27 Twp. 14 R. 13W

Well No. 6 Letsch

R. H. Shields Company

Contractor

FIRST REPORT

NW SE

330 Ft. from N. Line

_____ Ft. from S. Line

_____ Ft. from E. Line

330 Ft. from W. Line

SECTION PLAT

		o	

Location _____

Rig up _____

Drilling and Remarks:

RUCT

RECORD

Cased _____ in., _____ ft.

Sand _____

Gas _____

Oil _____

Total Depth _____

PRODUCTION

1st 24 hrs. Nat. _____

1st 24 hrs. after shot _____

Gas _____ Cu. Ft.

Dry Hole _____

Abandoned _____

Date

AUG 24 1938

19 _____ H. D. Hatfield Scout

Russell **KANSAS**Map No. _____ Sec. 27 Twp. 14 R. 13WWell No. 6 LetschR. H. Shields Company

Contractor

COMPLETED

NW SE

330 Ft. from N. Line

_____ Ft. from S. Line

_____ Ft. from E. Line

330 Ft. from W. Line**SECTION PLAT**

		0	

Location _____

Rig up _____

Drilling and Remarks:

18,000 Acid (TOTAL)POT 1808**RECORD**Cased 5 in., 2883 ft.Sand LENS 2845

Gas _____

Oil _____

Total Depth 2904**PRODUCTION**

1st 24 hrs. Nat. _____

1st 24 hrs. after shot _____

Gas _____ Cu. Ft.

Dry Hole _____

Abandoned _____

Date

OCT 19 1938

19

E. D. Hatfi