

KANSAS


Form 51-5M-7-39-Palace

Russell

Section 27 Township 14 Range 13-W

Well No. #7 Letsch

Company R. H. Shields et al

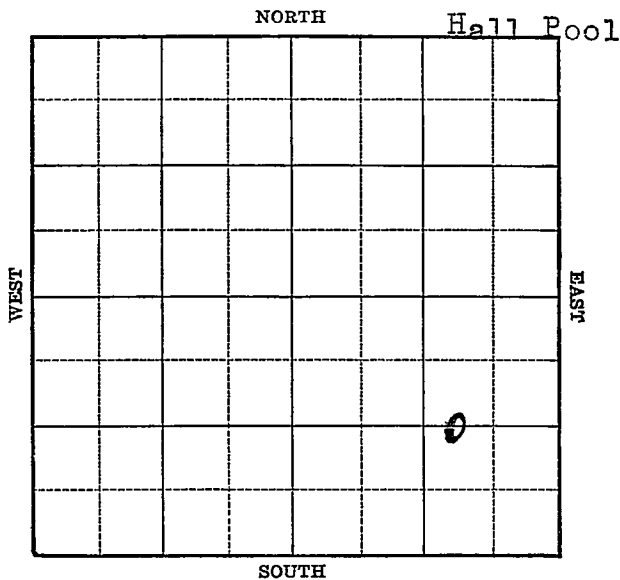

Sec. 27 Twp. 14 R. 13 -W

Well No. #7 Letsch Farm

R. H. Shields et al Company


(Hall)

1320 Ft. from N. Line

_____ Ft. from S. Line

990 Ft. from E. Line

_____ Ft. from W. Line

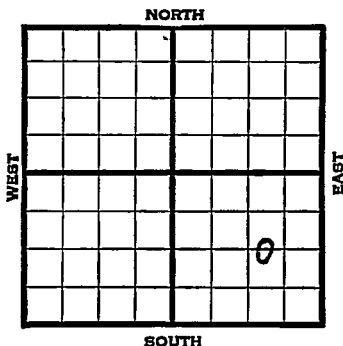

Elv. 1717

1939	REPORT
11/22	Material.
11/29	"
12/7	"
12/14	Rig.
12/21	20" - 32' 12" - 325'
	Drlg. 510'
12/28	Drlg. 1230'
1940	
1/4	10" - 640' S.S. Gas 1700'
	Drlg. 1915'
1/11	SD 2000'
1/18	S. Gas 2205' 8 1/4" - 2262'
	Drlg. 2745'
1/25	Lans. 2832' T.D. 2844'
	7" - 2844' WOC.
2/1	T.D. 2877' 2200' oil. 1200 acid
	Run rods.
	OVER

Map No. 72 Sec. 27 Twp. 14 R. 13W

Well No. 7 Letsch

R. H. Shields etal

Company

Contractor

FIRST REPORT

C W L E $\frac{1}{2}$ SE

1320 Ft. from N. Line

_____ Ft. from S. Line

990 Ft. from E. Line

_____ Ft. from W. Line

SECTION PLAT

			o

HALL POOL

Location _____

Rig up _____

Drilling and Remarks:

Material

RECORD

Cased _____ in., _____ ft.

Sand _____

Gas _____

Oil _____

Total Depth _____

PRODUCTION

1st 24 hrs. Nat. _____

1st 24 hrs. after shot _____

Gas _____ Cu. Ft.

Dry Hole _____

Abandoned _____

Date

NOV 22 1939 19

S. J. LEWIS

Scout

Map No. 72 Sec. 27 Twp. 14 R. 13W

Well No. 7 Letsch

R. H. Shields etal Company

Contractor

COMPLETED

C W L E $\frac{1}{2}$ SE

1320 Ft. from N. Line

_____ Ft. from S. Line

990 Ft. from E. Line

_____ Ft. from W. Line

SECTION PLAT

			0

HALL POOL

Location _____

Rig up _____

Drilling and Remarks:

Lane 2832.

7" @ 2845-

12000 Acid

Pump & Flow

3894

Maximum 3000

RECORD

Cased _____ in., _____ ft.

Sand _____

Gas _____

Oil _____

Total Depth 2827

PRODUCTION

1st 24 hrs. Nat. _____

1st 24 hrs. after shot _____

Gas _____ Cu. Ft.

Dry Hole _____

Abandoned _____

Date

FEB 7 1940 19

S. J. LEWIS Scout

1940
2/7

Lans. 2832'

7" - 2845'

T.D. 2877'

12,000 acid.

Pump & flow 3894 bbls.

Maximum 3000 bbls.

COMPLETED