


Section 5 Township 16 Range 1-W

Well No. #1 Karber

Company H S Williams
Hunter Pool

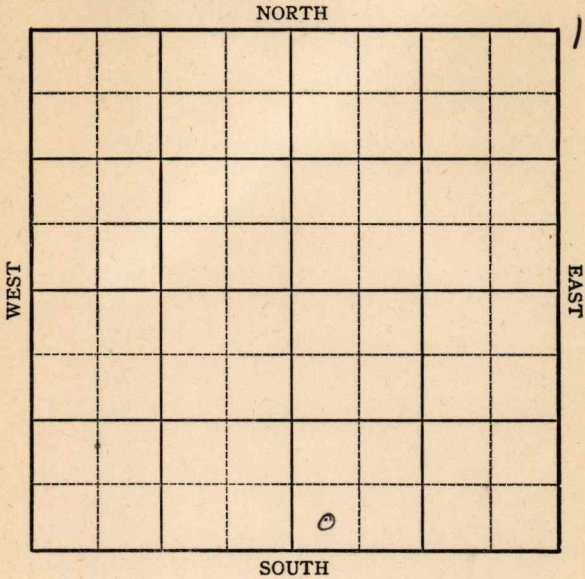

Sec. 5 Twp. 16 R. 1W

Well No. #1 Karber Farm

H. S. Williams Company

Jackson Contractor

Hunter Pool


_____ Ft. from N. Line

330' Ft. from S. Line

_____ Ft. from E. Line

330' Ft. from W. Line

SW SE

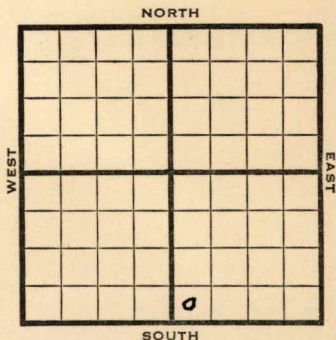

1949 **Elev 1306'** REPORT

11/9 8" @ 125'
Drlg. 2180'

11/16 **KC 2030'**
Miss 2663'
TD 2665'

11/23 5"@ 2660'
TD 2674'
Swb 6 bbls oil PH \neq 10% W

11/29

12/7 TD 2674'
Miss 2663'
5"@ 2660'
1000 acid
P_{mp} 50 Oil \neq 10% W Pot
38° Gr.

Comp

COMPLETED

Map No. _____ Sec. 5 Twp. 16 R. 1W

Well No. 1 Karber

H. S. Williams Company

Jackson Contractor

SW SE

FIRST REPORT
SECTION PLAT

| | | | |
|--|--|--|--|
| | | | |
| | | | |
| | | | |
| | | | |

_____ Ft. from N. Line

330 Ft. from S. Line

_____ Ft. from E. Line

330 Ft. from W. Line

Saline County

Location _____

Rig up _____

Drilling and Remarks:

8" @ 125

drlg. 2180

RECORD

Cased _____ in., _____ ft.

Sand _____

Gas _____

Oil _____

Total Depth _____

PRODUCTION

1st 24 hrs. Nat. _____

1st 24 hrs. after shot _____

Gas _____ Cu. Ft.

Dry Hole _____

Abandoned _____

Date

NOV 9 1949 19

S. J. LEWIS

Scout

Kansas

Map No. _____ Sec. 5 Twp. 16 R. 1W

Well No. 1 Karber

H. S. Williams Company

COMPLETE

Contractor

SW SE

E. 1206

SECTION PLAT

| | | | |
|--|--|--|--|
| | | | |
| | | | |
| | | | |
| | | | |

_____ Ft. from N. Line

330 Ft. from S. Line

_____ Ft. from E. Line

330 Ft. from W. Line

Saline County

RECORD

Location _____

Cased _____ in., _____ ft.

Rig up _____

Sand _____

Drilling and Remarks:

Gas _____

Oil _____

Total Depth 2624

Miss 2662
5" @ 2660
1000 acid
Run 50 ml + 10% 10'
OK
35° SW

PRODUCTION

1st 24 hrs. Nat. _____

1st 24 hrs. after shot _____

Gas _____ Cu. Ft.

Dry Hole _____

Abandoned _____

Date

DEC 7 1949

S. J. LEWIS Scout