

KANSAS

Form 51-5M-7-40-Palace


Russell

Section 27 Township 14 Range 13-W

Well No. #9 Letsch

Company R. H. Shields

NORTH Hall Pool

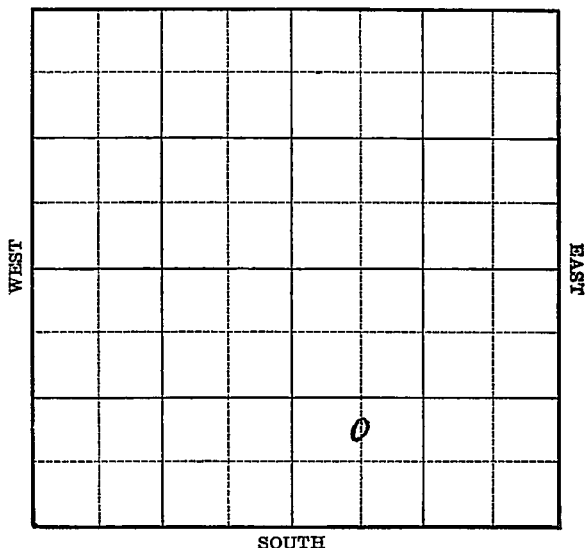

SOUTH

Sec. 27 Twp. 14 R. 13-W

Well No. #9 Letsch Farm

R. H. Shields Company


(Hall)

_____ Ft. from N. Line

990 Ft. from S. Line

_____ Ft. from E. Line

660 Ft. from W. Line

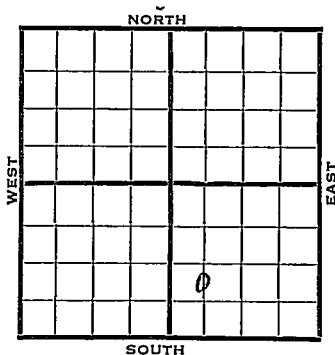

Elev. 1715

1940	REPORT
8/7	Ponds & Material.
8/14	Rigging up cable.
8/22	" " "
8/28	20" - 21' 12" - 326'
	Drlg. 640'
9/5	Anhy 630' 10" - 640'
	Drlg. 1540'
9/12	Show gas 2195-2208'
	Drlg. 2265'
9/19	8" - 2327' Topeka 2538'
	SSO 2690-95' Lans. 2835'
	7" - 2840' ^{2834'} Drlg.
9/26	Lans. 2824' 7" - 2834'
	5" - 2912' ^{2919'} T.D. 2918'
	2000' oil.
10/3	T.D. 2924' 2½ bailers oil per hour. Lower Pay 2919-24' Run tubing to test lower pay.
	5" - 2919' (Corrected)

OVER

1940
10/9

Lans. 2824'

5" - 2919'

T.D. 2924'

12,000 acid.

Potential 3256 bbls., pump.

COMPLETED

Map No. 72 Sec. 27 Twp. 14 R. 13WWell No. 9 LetschR. H. Shields

Company

Contractor

COMPLETED

C N L SW SE

 Ft. from N. Line990 Ft. from S. Line Ft. from E. Line660 Ft. from W. Line

HALL POOL

SECTION PLAT

Location Rig up

Drilling and Remarks:

*Case 2824**5" C 2919**12000 acid**Pump 3256 P.S.***RECORD**Cased in., ft.Sand Gas Oil Total Depth 2924**PRODUCTION**1st 24 hrs. Nat. 1st 24 hrs. after shot Gas Cu. Ft.Dry Hole Abandoned

Date

OCT 9 1940 19S. J. LEWIS Scout