


Section 27 Township 14 Range 13W

Well No. #12 Letsch

Company R. H. Shields.

Shields. Con.t  
NORTH

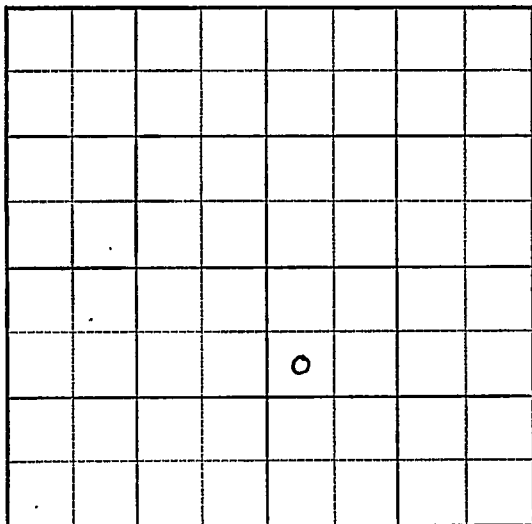

SOUTH

*[Faint, illegible handwritten notes or scribbles]*

# HOT FILE

Russell KANSAS  
14 R. 13W ✓

Sec. 27 Twp. 14 R. 13W

Well No. #12 Letsch Farm

R. H. Shields Company


Hall-Gurney Pool (Shields, Cont.) NORTH

990' Ft. from N. Line

\_\_\_\_\_ Ft. from S. Line

\_\_\_\_\_ Ft. from E. Line

330' Ft. from W. Line

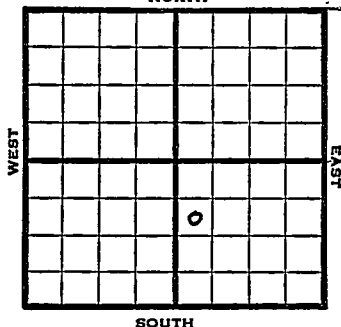

SW NW SE

1949 Elev. 1789' REPORT

8/17	Rig
8/24	15" @ 50' 12" @ 36' Drlg. 500'
8/31	10" @ 677' Drlg. 1560'
9/7	Tarkio 2205' 8" @ 2340' Drlg. 2405'
9/14	Topeka 2540' 6" @ 2720' Drlg 2721'
9/21	TD 2785' Rig burned Rigging up
9/28	Lansing 2870' TD 2880' 7" @ 2870'
10/5	Lansing 2861' TD 2880'
10/12	Drlg 2958'
10/19	"

OVER

1949

10/26 Lans 2861'  
7" @ 2890'  
Acid 500  
Pump 42 oil Pot.  
Gr. 40.9  
TD 2958'

**COMPLETED**

Map No. \_\_\_\_\_ Sec. 27 Twp. 14 R. 13W

Well No. 12 Letsch

R. H. Shields Company

Shields Contractor

S<sup>W</sup> NW SE

FIRST REPORT  
SECTION PLAT

990 Ft. from N. Line

\_\_\_\_\_ Ft. from S. Line

\_\_\_\_\_ Ft. from E. Line

330 Ft. from W. Line


Russell County

RECORD

Location \_\_\_\_\_

Cased \_\_\_\_\_ in., \_\_\_\_\_ ft.

Rig up \_\_\_\_\_

Sand \_\_\_\_\_

Drilling and Remarks:

Gas \_\_\_\_\_

Oil \_\_\_\_\_

Total Depth \_\_\_\_\_

Rig

PRODUCTION

1st 24 hrs. Nat. \_\_\_\_\_

1st 24 hrs. after shot \_\_\_\_\_

Gas \_\_\_\_\_ Cu. Ft.

Dry Hole \_\_\_\_\_

Abandoned \_\_\_\_\_

Date

AUG 17 1949 19

S. J. LEWIS Scout

Kansas

Map No. \_\_\_\_\_ Sec. 27 Twp. 14 R. 13W

Well No. 12 Letsch

R. H. Shields Company

**COMPLETE**

Contractor

SW NW SE

*E11789*  
**SECTION PLAT**

990 Ft. from N. Line

\_\_\_\_\_ Ft. from S. Line

\_\_\_\_\_ Ft. from E. Line

330 Ft. from W. Line


Russell County

Location \_\_\_\_\_

Rig up \_\_\_\_\_

Drilling and Remarks:

*Line 2861  
7" @ 2890'  
5000' sand*

*Pump 42 oil Pt*

*40' 1/2"*

**RECORD**

Cased \_\_\_\_\_ in., \_\_\_\_\_ ft.

Sand \_\_\_\_\_

Gas \_\_\_\_\_

Oil \_\_\_\_\_

Total Depth 2955'

**PRODUCTION**

1st 24 hrs. Nat. \_\_\_\_\_

1st 24 hrs. after shot \_\_\_\_\_

Gas \_\_\_\_\_ Cu. Ft.

Dry Hole \_\_\_\_\_

Abandoned \_\_\_\_\_

Date

OCT 26 1949 19

S. I. LEWIS

Scout