


SECTION 7 TOWNSHIP 16 RANGE 1W

WELL NO. #1 Currie

COMPANY Willis Waterman & Ingling

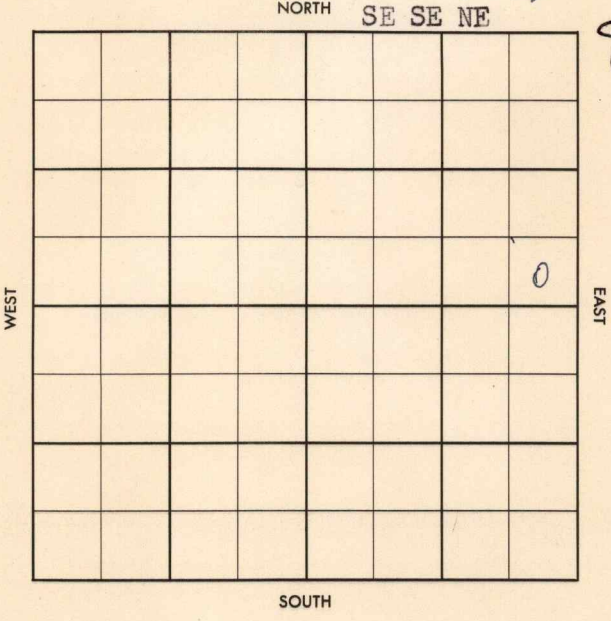

CORRECTION

FORM 513 SUNRAY

Co.

Use

No.

Sec.

T.

R.

County Saxine Elev. 1318 DF
 Sec. 7 Trwp. 16 Rge. 1W
 Company Willis Waterman & 179/179
 Farm Name Currie No. 1

TOPS	DEPTH	LOG	DATUM	Loc. in Sec.
Anh.				SE SE NE
Tr.				
H.	1829			
Tr.	1834			
Dg. sd	1857			
Bl.	1977			
L.				Geol.
K.C.	2041			Contr.
B.K.C.				Inclining
Ce.				Hunter No.
C.	2665			Pool
M.	2674			Semi-Wildcat
M.				
K.				
Mz.				
Ma.				
V.				
S.				
S.				
A				
R.				
PE.				
G.				
T.D.	2686			COMPLETE

MAY 1 '57

o

COMPLETE

Date Comm.

Location Feb 27 57 Loc. MAR 3 57 X

Spd 2-28-57 8 5/8 118 @ 475

@ 750 @ 2425

5 1/2 2680/50 CO DD 2691

FU 100' oil 1/2" @ 1 1/2 Bophr

6 hrs FU 250' oil + 100 wh

in 12 hrs @ 1 1/4 Bophr no/w

to DD. MAR 27 57 DD 2698 1/2 @

20 Bophr @ rate 40 Bophr

+ 10 Bophr PIP APR 3 57 APR 10 57 APR 17 57

FORM 513-1 SUNRAY

APR 24 '57 . MAY 1 '57 P 15 Bopdt

TR wtr

7-16-1W

SE SE NE

