

KANSAS

FORM 51 5M 1-42 PETROL


Saline

Section 8 Township 16 Range 1-W

Well No. #1 Andrews

Company Adikins Oil

Wildcat

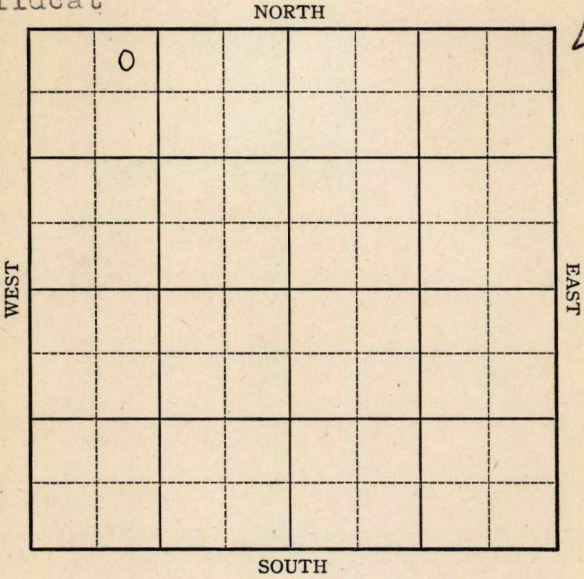

KANSAS

Saline

Sec. 8 Twp. 16 R. 1W

Well No. #1 Andrews Farm

Adikins Oil Company

Wildcat


330 Ft. from N. Line

_____ Ft. from S. Line

_____ Ft. from E. Line

990 Ft. from W. Line

NE NW NW

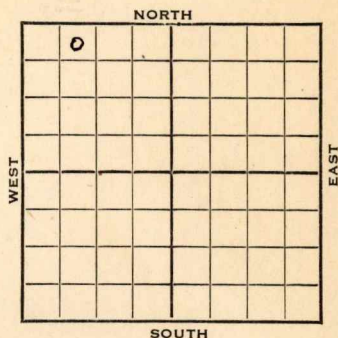

1942

REPORT

11/10	Derrick
11/18	Drlg. 800 8" @ 100'
11/24	Drlg. 2405'
12/2	Miss. 2672 T.D. 2719& Water

ABANDONED

KANSAS

Map No. 42 Sec. 8 Twp. 16 R. 1W

Well No. 1 Andrews

Adikins Oil Company

FIRST REPORT Contractor

NE NW NW

SECTION PLAT

330 Ft. from N. Line

o			

_____ Ft. from S. Line

_____ Ft. from E. Line

990 Ft. from W. Line

WILDCAT

RECORD

Location _____

Cased _____ in., _____ ft.

Rig up _____

Sand _____

Drilling and Remarks:

Gas _____

Oil _____

Total Depth _____

Derrick

PRODUCTION

1st 24 hrs. Nat. _____

1st 24 hrs. after shot _____

Gas _____ Cu. Ft.

Dry Hole _____

Abandoned _____

Date

NOV 11 1942

19

S. J. LEWIS

Scout

Saline

KANSAS

Map No. 42 Sec. 8 Twp. 16 R. 1W

Well No. 1 Andrews

Adikins Oil Company

ABANDONED Contractor

NE NW NW

SECTION PLAT

330 Ft. from N. Line

_____ Ft. from S. Line

_____ Ft. from E. Line

990 Ft. from W. Line

6		

WILDCAT

Location _____

Rig up _____

Drilling and Remarks:

*Miss 2672.
Water.*

RECORD

Cased _____ in., _____ ft.

Sand _____

Gas _____

Oil _____

Total Depth 2719

PRODUCTION

1st 24 hrs. Nat. _____

1st 24 hrs. after shot _____

Gas _____ Cu. Ft.

Dry Hole _____

Abandoned _____

Date

DEC 2 1942

19

S. J. LEWIS

Scout