


Section 8 Township 16 Range 1 W

Well No. # 1 Johnson "B"

Company F. S. Williams

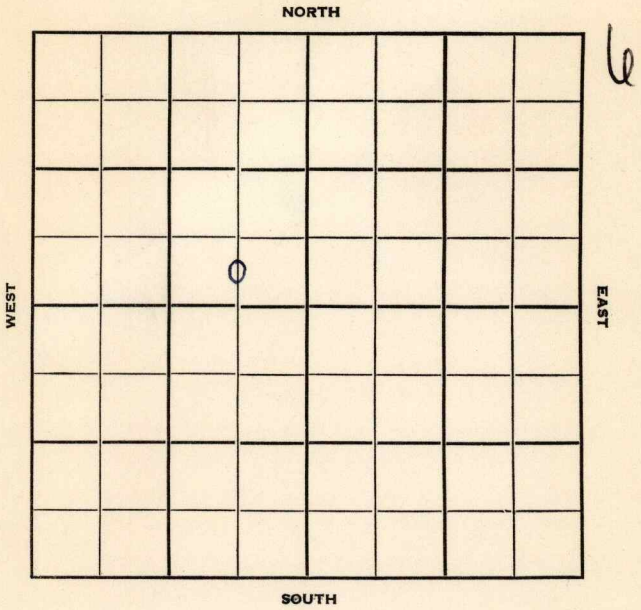

Saline

KANSAS

Sec. 8 Twp. 16 R. 1 W

Well No. # 1 Johnson "B" Farm

F. S. Williams Company

Mallard Drlg. Contractor

Hunter Pool

Ft. from N. Line


330 Ft. from S. Line

660 Ft. from E. Line

Ft. from W. Line

C S L SE NW

Deep Rock Farmout

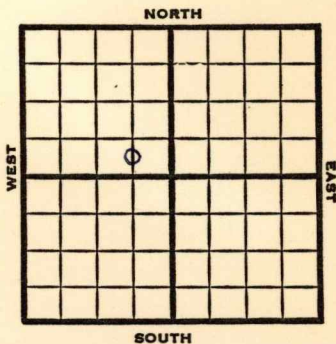

1951

Elev. 1328'

REPORT

9/26

Spud 9-22-51
8" @ 124

10/17

Drlg. 1275'
Spud 9-22-51
Oil Well TD 2700
8" @ 124

Miss 2664-67 5" @ 2661

TD 2700 2 boph 1 bw Comp. 25 bopd

COMPLETED

County **Saline** State **Kansas**

Sec. **8** (Blk. Twp.) **16** (Sur. Rge.) **1W** Map No.

Operator **F. S. Williams**

Well No. **1** Farm **Johnson "B"**

Elev. Location **C S L SE NW**

330 Ft. From **S** Line **NW**
660 Ft. From **E** Line **Quarter**

1st. Report **SEP 26 1951**

Completion

Remarks **Deep Rock farmout**
Mallard Drlg. - Contr.

Spudding Date **9-22-51**

Drlg. Data **Hunter Pool**

8" @ 124 drlg. 1275

FIRST REPORT

