


Salina

KANSAS

SECTION 8 TOWNSHIP 16 RANGE 1W

WELL NO. #2 James

COMPANY F.S. Williams

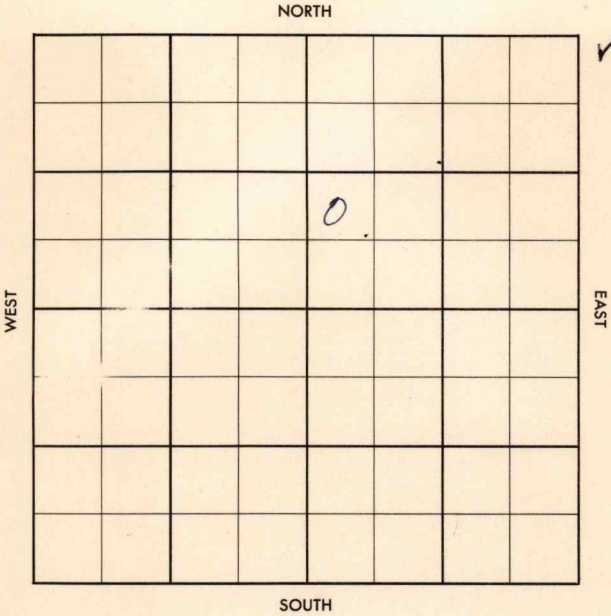

Saline

KANSAS

SEC.	TWP.	R.
8	16	1W

WELL NO. #2 James FARM

COMPANY F. S. Williams


CONTRACTOR

_____ FT. FROM N. LINE

_____ FT. FROM S. LINE

_____ FT. FROM E. LINE

_____ FT. FROM W. LINE

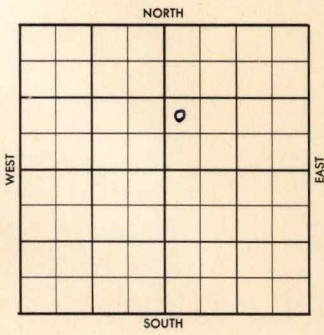

NW SW NE

1956	ELEVATION	REPORT
------	-----------	--------

9-12	Location	
------	----------	--

County Saline Elev. 1315
 Sec. 8 Twp. 16 Rge. 1W
 Company F. S. Williams
 Farm Name James No. 2

TOPS	DEPTH	LOG	DATUM	Loc. in Sec.
Anh.				NW SW NE
Tr.				
Dg.				
Bl.				
L.				Geol.
K.C.				Contr.
B.K.C.				
Ce.				
C.				
M.	2670			Pool
M.				
K.				
Mz.				
Ma.				
V.				
S.				
S.				
A.				
R.				
PE.				
G.				
TD.	2673			



Date Comm. OCT 10 1956
 Location SEP 19 '56 9-14-56 80/8
140/125 17 1830 SEP 26 '56 5 1/2
Q 2671/150 MICT OCT 10 '56
DD 2690 TD 11 8 1 Bot + 1/2
Bwph Pop = P. 15 Bopd
+ 6 Bwph