


Section 8 Township 16 Range 1W

Well No. #2 Swisher

Company F.S. Williams

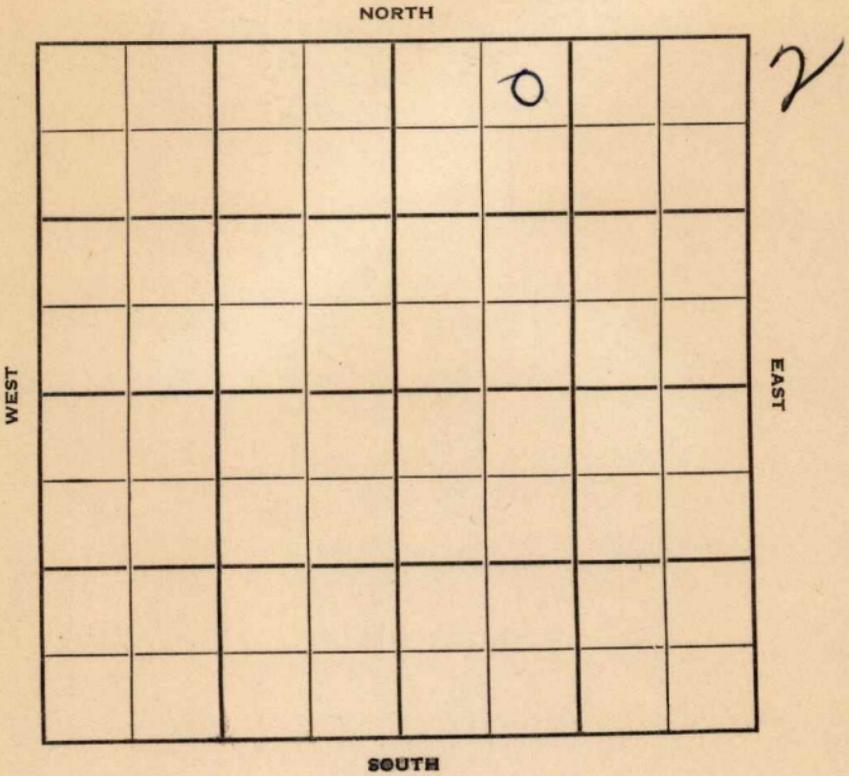

Saline
16

KANSAS

Sec. 8 Twp. 16 R. 1W ✓

Well No. #2 Swisher Farm

F. S. Williams Company

Mallard Drlg. Contractor

North Hunter


330' Ft. from N. Line

_____ Ft. from S. Line

_____ Ft. from E. Line

990' Ft. from W. Line

NE NW NE

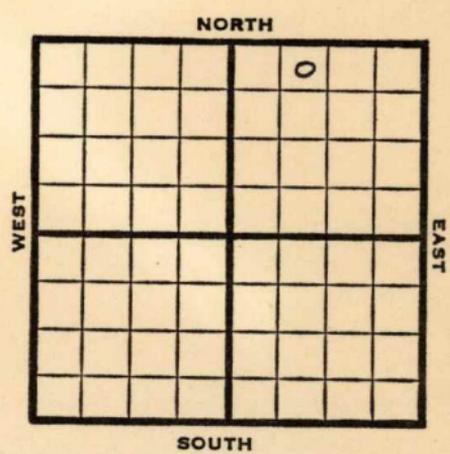

1950 Elev 1287' REPORT

5/3 Rig up

5/17 TD 2651
8 5/8" @ 146

Miss 2645

5" @ 2648

25 BOPD

Completed

COMPLETED

Kansas

North Hunter

Map No. _____ Sec. 8 Twp. 16 R. 1W

Well No. 2 Swisher

F. S. Williams Company

Mallard Drlg. Contractor

NE NW NE


SECTION PLAT

330 Ft. from N. Line

_____ Ft. from S. Line

_____ Ft. from E. Line

990 Ft. from W. Line

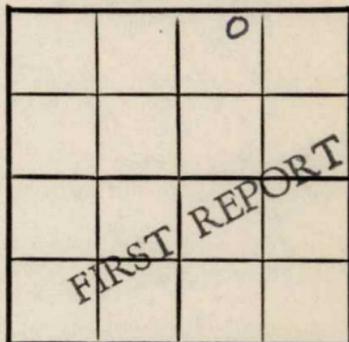

Saline County

Location _____

Rig up X

Drilling and Remarks: _____

RECORD

Cased _____ in., _____ ft.

Sand _____

Gas _____

Oil _____

Total Depth _____

PRODUCTION

1st 24 hrs. Nat. _____

1st 24 hrs. after shot _____

Gas _____ Cu. Ft.

Dry Hole _____

Abandoned _____

Date

MAY 3 1950 19

J. E. TYRA Scout

Map No. _____ Sec. 8 Twp. 16 R. 1W

Well No. 2 Swisher

_____ F. S. Williams _____ Company

_____ Contractor

NE NW NE

E1. 1287


SECTION PLAT

330 Ft. from N. Line

_____ Ft. from S. Line

_____ Ft. from E. Line

990 Ft. from W. Line

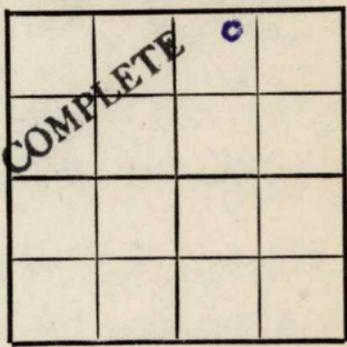

Saline

Location _____

Rig up _____

Drilling and Remarks:

8 5/8" @ 146
miss 2645
5" @ 2648
25 BOPD
d

RECORD

Cased _____ in., _____ ft.

Sand _____

Gas _____

Oil _____

Total Depth 2651

PRODUCTION

1st 24 hrs. Nat. _____

1st 24 hrs. after shot _____

Gas _____ Cu. Ft.

Dry Hole _____

Abandoned _____

Date

MAY 17 1950

19

J. E. TYRA

Scout