


Section 9 Township 16 Range 1 W

Well No. # 1 Schweizerhof

Company Deep Rock

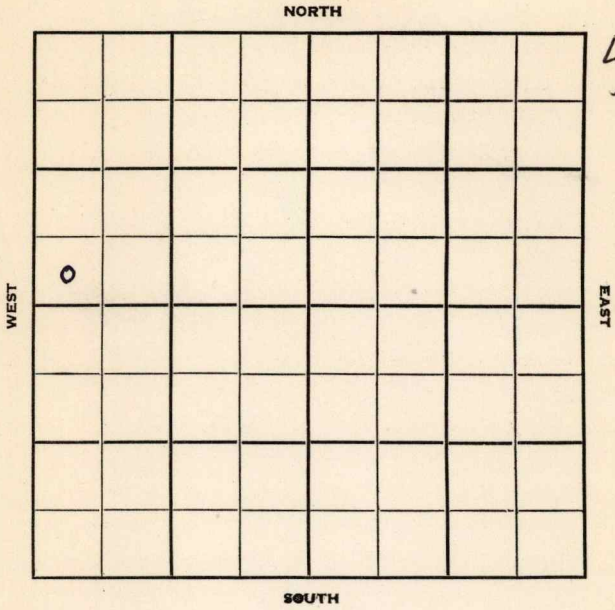

Saline

KANSAS

Sec. 9 Twp. 16 R. 1W

Well No. #1 Schweizerhof Farm

Deep Rock Company

Contractor


Ft. from N. Line

330' Ft. from S. Line

Ft. from E. Line

330' Ft. from W. Line

SW SW NW

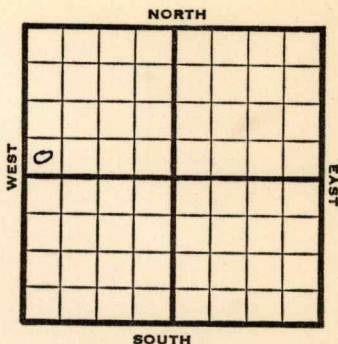

1951

Elev. 1306' REPORT

2/21

Location

3/21

Spud 3-1-51

D&A TD 2745

10" @ 146'

DST 1761-1800 opn 35 min

Rec. 30' mud

Miss 2680

DST 2691-2701 opn 1 hr

Rec. 120' water **Miss 2692**

TD 2745 D&A

ABANDONED


County Saline State Kansas

Sec. 9 (Blk.) 16 (Sur.) 1W Map No.

Operator Deep Rock

Well No. 1 Farm Schweizerhof

Elev. _____ Location SW SW NW

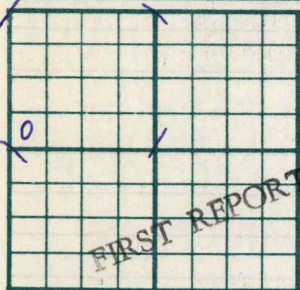

330 Ft. From S Line NW

330 Ft. From W Line Quarter

1st. Report FEB 21 1951

Completion _____

Remarks _____

Spudding Date _____

Drig. Data _____

Location


County Saline State Kansas

Sec. 9 (Blk. 16) (Sur. 1W) (Twp.) (Rge.) Map No.

Operator Deep Rock

Well No. 1 Farm Schweizerhof

Elev. 1306 Location SW SW NW

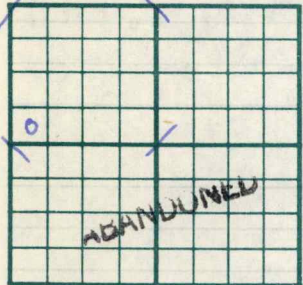

330 Ft. From S Line NW
330 Ft. From W Line Quarter

Ist. Report

Completion MAR 21 1951

Remarks

Beardmore - Contr.

Spudding Date 3-1-51

Drlg. Data D & A TD 2745

10" @ 146 DST 1761-1800 open 35 min.

Rec. 30' mud Miss. 2680 DST 2691-2701

open 1 hr. Rec. 120' water Miss. 2692

TD 2745

D & A