

Saline

KANSAS

8

16

1W

SECTION _____ TOWNSHIP _____ RANGE _____

WELL NO. #3 Johnson "B"

COMPANY Tess Williams

NORTH

			0				

WEST

EAST

SOUTH

11

Saline

KANSAS

SEC. 8	TWP. 16	R. 1W
-----------	------------	----------

WELL NO. #3 Johnson "B" FARM

COMPANY Tess Williams


CONTRACTOR Mallard Tools
Hunter No.

_____ FT. FROM N. LINE

_____ FT. FROM S. LINE

_____ FT. FROM E. LINE

_____ FT. FROM W. LINE

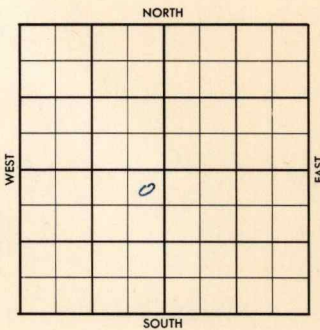

NE NE SW

1956	ELEVATION	REPORT
------	-----------	--------

9-5 Loc

County Saline Elev. 1349 1342
 Sec. 8 Twp. 16 Rge. 1W
 Company Tess Williams
 Farm Name Johnson "B" No. 3

Co.

TOPS	DEPTH	LOG	DATUM	Loc in Sec.
Anh.				
Tp.				NE NE SW
H.				4400' EL
Tr.				
Dg.				
Bl.				
L.	> 2052			
K.C.				Geol.
B.K.C.				Contr.
Ce.				
C.				Mallard Tool
M. <u>L1</u>	<u>2675</u>			Pool
M.				
K.				Hunter No.
Nz.				
Ma.				
V.				
S.				SEP 26 '56
S.				
A.				
R.				
Pe.				
G.				COMPLETE
TD	<u>2685</u>			

Use

No.

Date Comm. Location SEP 2 '56 9-7-56
 8 7/8 160/125 # 1850 SEP 19 '56
 5 1/2 2685/75 SEP 26 '56 Co. DD 2705
 TD \wedge P. 30 B0 + 60 Bwpd.

Sec.

T.

R

County Saline Elev. _____
 Sec. 8 Twp. 16 Rge. 1W
 Company Tess Williams
 Farm Name Johnson "B" No. 3

TOPS	DEPTH	LOG	DATUM	Loc. in Sec.						
Anb.				NE NE SW						
Tp.										
H.										
Tr.										
Dg.										
Bl.										
L.				Geol. _____						
K.C.				Contr. _____						
B.K.C.				Mallard Tools						
Ce.				Pool						
C.				Hunter No. _____						
M.				<table border="1"> <tr> <td colspan="2">FIRST REPORT</td> </tr> <tr> <td>0</td> <td></td> </tr> <tr> <td>SEP 5 '56</td> <td></td> </tr> </table>	FIRST REPORT		0		SEP 5 '56	
FIRST REPORT										
0										
SEP 5 '56										
M.										
K.										
Mz.										
Mq.										
V.										
S.										
S.										
A.										
R.										
Pe.										
G.										
T.D.										

Date Comm. Location

[Large blue scribble]

SEP 1 1956

SEP 5 '56

Co.
Lsg.
No.
Sec.
T.
R.