


Section 25 Township 16 Range 13~~W~~

Well No. #4 Woydziak "B"

Company N C R A
Susank Pool

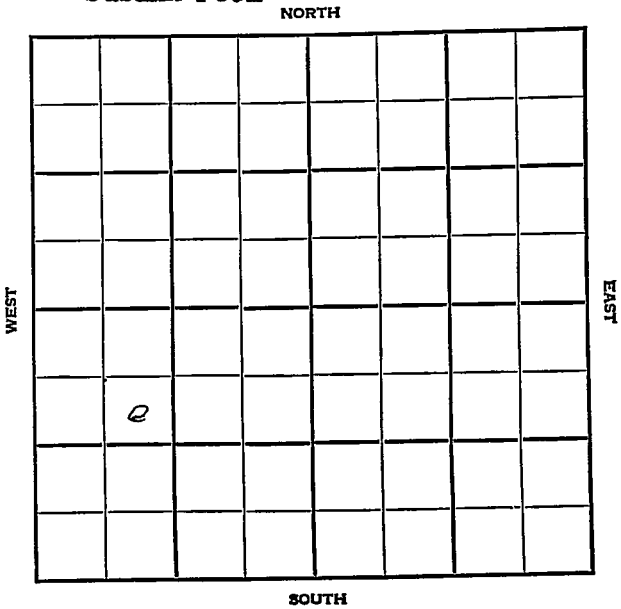

Sec. 25 Twp. 16 R. 13W

Well No. #4 Woydziak "B" Farm

N. C. R. A. Company

Susank


990 Ft. from N. Line

 Ft. from S. Line

 Ft. from E. Line

990 Ft. from W. Line

SE NW SW

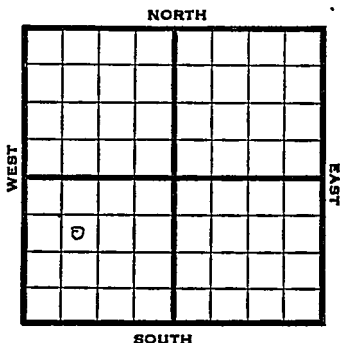

1948

Elev. 1921' REPORT

4/14

8" @ 285'

WOC

4/21

Dr lg. 2620'

4/28

Arbuckle 3306'

TD 3309'

5" @ 3307'

RUST

5/5

"

5/12

TD 3397'

250 Acid

5/19

PB 3392'

Swb 25 bbls water & 15 bbls oil 24 hrs.

5/26

Swb 18 bbls oil & 19 W PH

6/1

"

6/9

Arb. 3306'

5" @ 3307'

Pump 301 oil / 55% W pot

Gr. 39.0

TD 3397'

Comp.

COMPLETED

Map No. _____ Sec. 25 Twp. 16 R. 13WWell No. 4 Woydziak "B"N C R A_____
Company**FIRST REPORT**_____
Contractor

SE NW SW

SECTION PLAT

990 Ft. from N. Line_____
Ft. from S. Line_____
Ft. from E. Line990 Ft. from W. Line

Barton County

Location _____

Rig up _____

Drilling and Remarks:

8" @ 285 WOC

RECORD

Cased _____ in., _____ ft.

Sand _____

Gas _____

Oil _____

Total Depth _____

PRODUCTION

1st 24 hrs. Nat. _____

1st 24 hrs. after shot _____

Gas _____ Cu. Ft.

Dry Hole _____

Abandoned _____

Date

APR 14 194819S. J. LEWISScout

