

KANSAS


Russell

Form 51-5M-7-39-Palace

Section 26 Township 14 Range 13W

Well No. #4 Hall

Company Texon

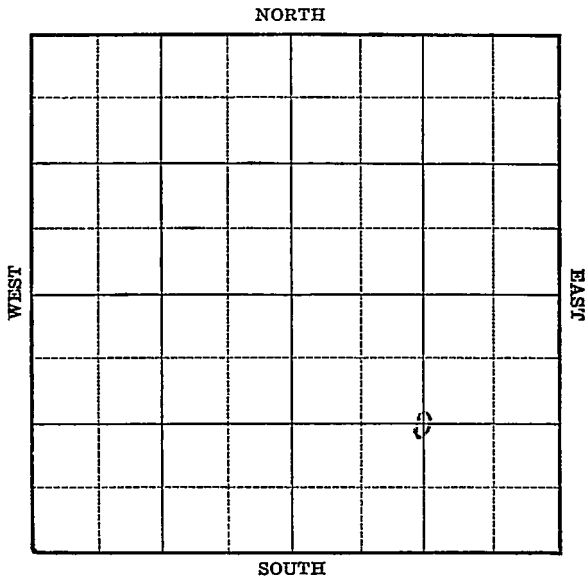

Sec. 26 Twp. 14 R. 13-W

Well No. #4 Hall Farm _____

Texon Company _____

(Hall)


_____ Ft. from N. Line

1320 Ft. from S. Line

1320 Ft. from E. Line

_____ Ft. from W. Line

Elev. 1711

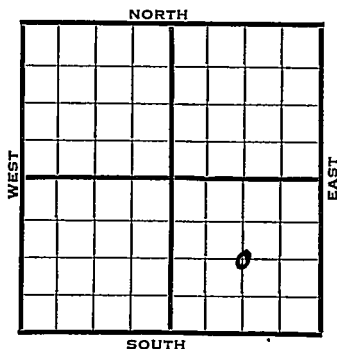

1940	REPORT
7/2	Derrick.
7/11	10" - 381' Drlg. 2455'
7/18	Lans. 2844' ^{2854'} 6" - 2863'
	Drlg. 2915'
7/25	Lans. 2854' (Corrected)
	6" - 2873' T.D. 2915'
	10,500 acid. Testing.
7/31	Lansing 2854'
	T.D. 2915'
	10,500 acid.
	6000 acid.
	Potential 743 bbls.
	COMPLETED

Map No. 72 Sec. 26 Twp. 14 R. 13W

Well No. 4 Hall

Texon Company

Contractor

FIRST REPORT

C SE

_____ Ft. from N. Line

1320 Ft. from S. Line

1320 Ft. from E. Line

_____ Ft. from W. Line

HALL POOL

SECTION PLAT

Location _____

Rig up _____

Drilling and Remarks:

Derrick

RECORD

Cased _____ in., _____ ft.

Sand _____

Gas _____

Oil _____

Total Depth _____

PRODUCTION

1st 24 hrs. Nat. _____

1st 24 hrs. after shot _____

Gas _____ Cu. Ft.

Dry Hole _____

Abandoned _____

Date

JUL 2 1940 19

S. J. LEWIS Scout

