


Section 26 Township 14 Range 13-W

Well No. 5 Hall

Company Texon

NORTH Hall Gurney Lans.

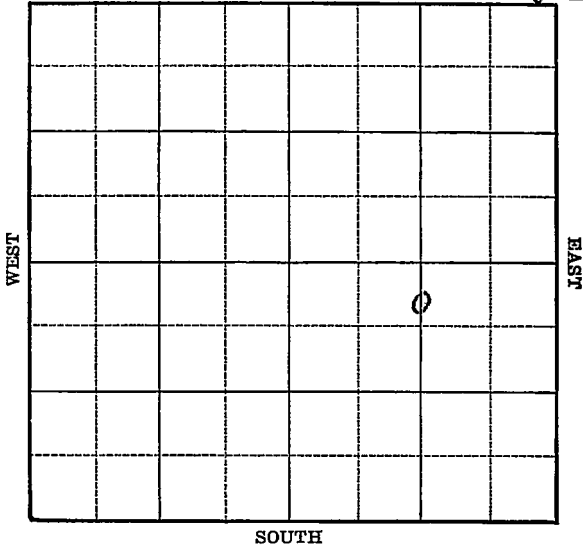

Map No. 72 Sec. 26 Twp. 14 R. 13WWell No. 5 HallTexon

Company

Contractor

FIRST REPORT

C N L SE

440 Ft. from N. Line

_____ Ft. from S. Line

1320 Ft. from E. Line

_____ Ft. from W. Line

HALL GURNEY LANS.

SECTION PLAT

			o

Location _____

Rig up _____

Drilling and Remarks:

S.H.

RECORD

Cased _____ in., _____ ft.

Sand _____

Gas _____

Oil _____

Total Depth _____

PRODUCTION

1st 24 hrs. Nat. _____

1st 24 hrs. after shot _____

Gas _____ Cu. Ft.

Dry Hole _____

Abandoned _____

Date

JAN 8 1941 19 _____

S. J. LEWIS Scout

Map No. 72 Sec. 26 Twp. 14 R. 13WWell No. 5 HallTexon

Company

Contractor

COMPLETED

C N L SE

440 Ft. from N. Line Ft. from S. Line1320 Ft. from E. Line Ft. from W. Line**SECTION PLAT**

HALL-GURNEY LANS.

Location _____

Rig up _____

Drilling and Remarks:

*Case 2849**6" @ 2878**8000 acid**Pump. 255 P.Y.**38.3 Gr.***RECORD**

Cased _____ in., _____ ft.

Sand _____

Gas _____

Oil _____

Total Depth 2921**PRODUCTION**

1st 24 hrs. Nat. _____

1st 24 hrs. after shot _____

Gas _____ Cu. Ft.

Dry Hole _____

Abandoned _____

Date

JAN 29 1941 19

S. J. LEWIS Scout