


Section 34 Township 14 Range 13W

Well No. 1 - Shaffer

Company Beamer Drlg

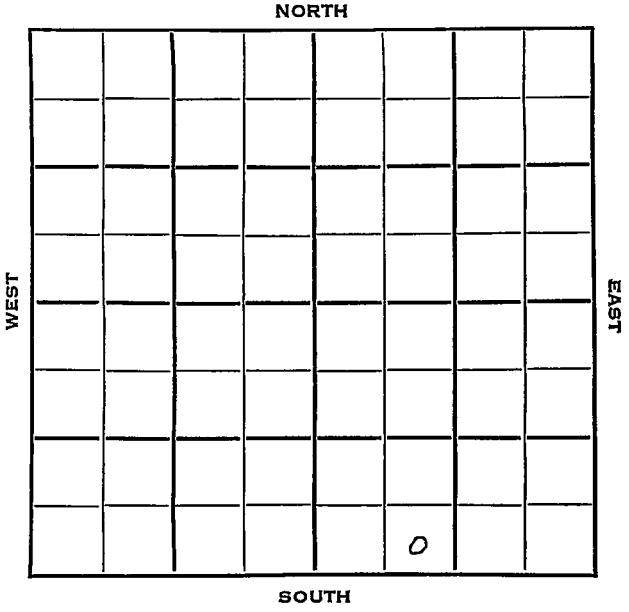

Russell KANSAS ✓

Sec. 34 Twp. 14 R. 13 W

Well No. # 1 Shaffer Farm

Beamer Drlg. Company

Contractor


Ft. from N. Line

330 Ft. from S. Line

Ft. from E. Line

990 Ft. from W. Line

SE SW SE

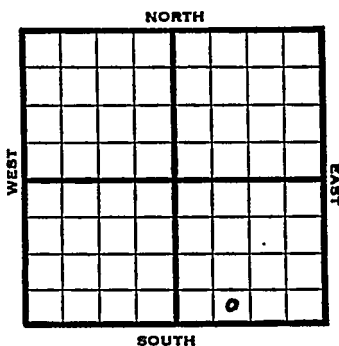

1952 Elev. 1750' REPORT

12/30 Drilling
 1/1 Drlg.
 1/8 8" @ 2210 Top 2615 ϕ 2680
 1/22 TD 3185' 7" @ 2927'
 1/29 NR..
 2/5 Lans. 2920' Cong 3218-30'
 Arb. 3230-42' RTD 5" @ 2408
 2/12 CO 2402' /2280-94 Hyd. wtr. sq.
 2/19 /2291-2300 /2310-20 Sd-frac.
 2/25 Spud 12-6-52 Oil well TD 3242'
 8" @ 2210 Tarkio 2283 Top 2615
 Lans. 2920 Cong. 3218 Arb. 3230
 7" @ 2927 TD 3242 5" @ 2408
 CO to 2402 Perf/2291-2300
 2310-20 Sd-frac.
 Comp. 20 BOPD 80% wtr.

COMPLETED

