

# KANSAS

Form 51-5M-7-40-Palace


Russell

Section 26 Township 14 Range 13-W

Well No. 6 Hall

Company Texon

NORTH Hall Gurney Lans.

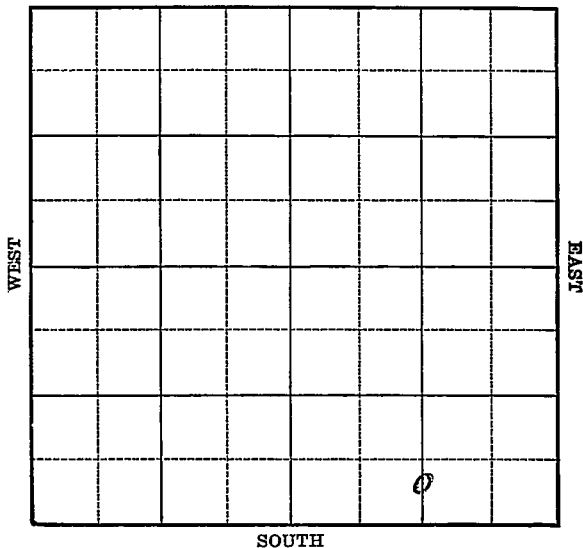



Map No. 72 Sec. 26 Twp. 14 R. 13WWell No. 6 HallTexon

Company

Contractor

**FIRST REPORT**

C S L SE

       Ft. from N. Line440 Ft. from S. Line1320 Ft. from E. Line       Ft. from W. Line

Hall Gurney Lans.

**SECTION PLAT**


Location XRig up       

Drilling and Remarks:

**RECORD**Cased        in.,        ft.Sand       Gas       Oil       Total Depth       **PRODUCTION**1st 24 hrs. Nat.       1st 24 hrs. after shot       Gas        Cu. Ft.Dry Hole       Abandoned       

Date

JAN 8 1941 19S. J. LEWIS Scout

Map No. 72 Sec. 26 Twp. 14 R. 13WWell No. 6 Hall

Texon

Company

Contractor

**COMPLETED**

C S L SE

\_\_\_\_\_ Ft. from N. Line

440 Ft. from S. Line1320 Ft. from E. Line

\_\_\_\_\_ Ft. from W. Line

HALL-GURNEY LANS.  
POOL**SECTION PLAT**


Location \_\_\_\_\_

Rig up \_\_\_\_\_

Drilling and Remarks:

*Lans. 2842**6" C 2857**7000 acid**Pump 410 BT**38.3 Gr***RECORD**

Cased \_\_\_\_\_ in., \_\_\_\_\_ ft.

Sand \_\_\_\_\_

Gas \_\_\_\_\_

Oil \_\_\_\_\_

Total Depth 2900**PRODUCTION**

1st 24 hrs. Nat. \_\_\_\_\_

1st 24 hrs. after shot \_\_\_\_\_

Gas \_\_\_\_\_ Cu. Ft.

Dry Hole \_\_\_\_\_

Abandoned \_\_\_\_\_

Date

FEB 12 1941

S. I. LEWIS Scout