


Section 26 Township 14 Range 13-W

Well No. 2 - Letsch

Company Texon

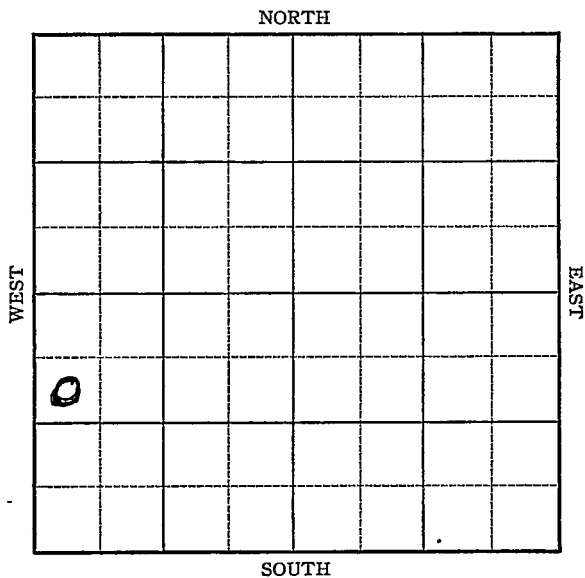

Sec. 26 Twp. 14 R. 13-W

Well No. #2 Letsch Farm

Texon Company


990 Ft. from N. Line

_____ Ft. from S. Line

_____ Ft. from E. Line

330 Ft. from W. Line

Elev. 1689

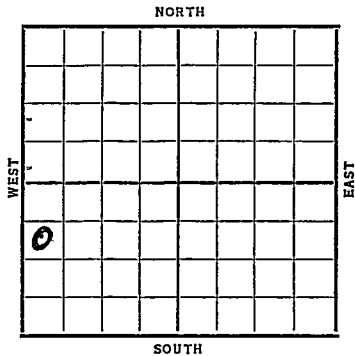

Date	REPORT
1937	
9/8	Moving in.
9/17	10" @ 282'. T.D. 290'. WOC.
9/24	Drl g. 2550'.
10/2	K.C. 2805'.
10/6	7" 2822 Big Pay 2842-57
	2000 feet oil in hole 10 hours
	Dlg. 2932 (Tel)
10/15	T.D. 2940 2000' 2200' oil
	7000 acid
10/16	Potential 2601 bbls. after 7000
	acid (Telegram)
	OVER

1937

10/20 10" @ 282'.

7" @ 2822'.

K.C. 2805'.

T.D. 2940'.

7,000 acid.

Pump 433.5 bbls. 4 hrs &

598.5 bbls. 4 hrs.

Potential 2601 bbls.

COMPLETED

~~2~~ .

Map No. 72 Sec. 26 Twp. 14 R. 13W

Well No. 2-Letsch

Tepco Company

Contractor

FIRST REPORT

SECTION PLAT

990 Ft. from N. Line

_____ Ft. from S. Line

_____ Ft. from E. Line

330 Ft. from W. Line

0			

Location _____

Rig up _____

Drilling and Remarks:

Nothing in

RECORD

Cased _____ in., _____ ft.

Sand _____

Gas _____

Oil _____

Total Depth _____

PRODUCTION

1st 24 hrs. Nat. _____

1st 24 hrs. after shot _____

Gas _____ Cu. Ft.

Dry Hole _____

Abandoned _____

Date

SEP 8 1937

19

H. D. Hatfield

Scout

Russell **KANSAS**

Map No. 72 Sec. 26 Twp. 14 R. 13W

Well No. 2 Letsch

Texon Company

Contractor

COMPLETED

SW NW SW

990 Ft. from N. Line

_____ Ft. from S. Line

_____ Ft. from E. Line

330 Ft. from W. Line

SECTION PLAT

0			

Location _____

Rig up _____

Drilling and Remarks:

7,000 Acid

P-433.5/4 + 598.5/4

POT-2601

10" - 282
RECORD

Cased 7 in., 2822 ft.

Sand Kc - 2805

Gas _____

Oil _____

Total Depth 2940

PRODUCTION

1st 24 hrs. Nat. _____

1st 24 hrs. after shot _____

Gas _____ Cu. Ft.

Dry Hole _____

Abandoned _____

Date

OCT 20 1937 19

H. D. Hatfield Scout