


Section 17 Township 16 Range 1W

Well No. 1 Karber

Company Musgrove Pet.

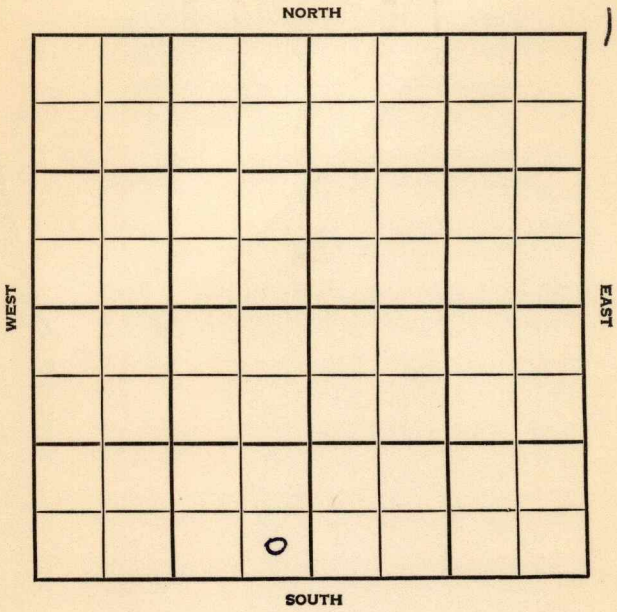

Saline KANSAS

SEC.	TWP.	R.
17	16	1W
WELL NO.		
1 Karber		FARM
COMPANY		
Musgrove Pet		
CONTRACTOR		

Hunter Pool

Ft. from N. Line


330

Ft. from S. Line

330

Ft. from E. Line

Ft. from W. Line

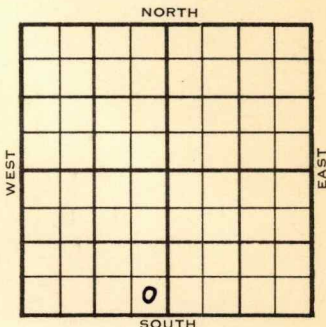

SE SE SW

	ELEVATION	REPORT
1951	1345'	
11/7		Spdg 7-12-54 8" @ 123 WOC
7/21	Miss 2682'	DST 2683-90', 1 hr., 15' oil, 40' OCM, 590# RTD 2690' 5" @ 2684' Schl
8/4		Spud 7-12-54 - D&A TD 2690' 8" @ 123' Heeb 1849', Doug. 1881', Miss 2682' DST 2683-90', opn 1 hr., rec. 15' oil, 40' ocm, 590# TD 2690' 5" @ 2684' CO to 2690' 8 go 8 gwph frac s/ 1/4 bo 17bw PB 1890' 10/1887-90, S/5 gwph 250A D&A

ABANDONED

County Saline State Kansas

Sec. 17 (Blk. Twp.) 16 (Sur. Rge.) 1W Map No.

Operator Musgrove Pet.

Well No. 1 Farm Karber

Elev. \_\_\_\_\_ Location SE SE SW


FIRST REPORT

0

330 Ft. From S Line SW

330 Ft. From E Line Quarter

1st. Report JUL 14 1954

Completion \_\_\_\_\_

Remarks \_\_\_\_\_

Spudding Date 7-12-54

Drlg. Data Hunter Pool

8" @ 123 WOC

