


Section 17 Township 16 Range 1-W

Well No. # 2 E. Tressin

Company Deep Rock

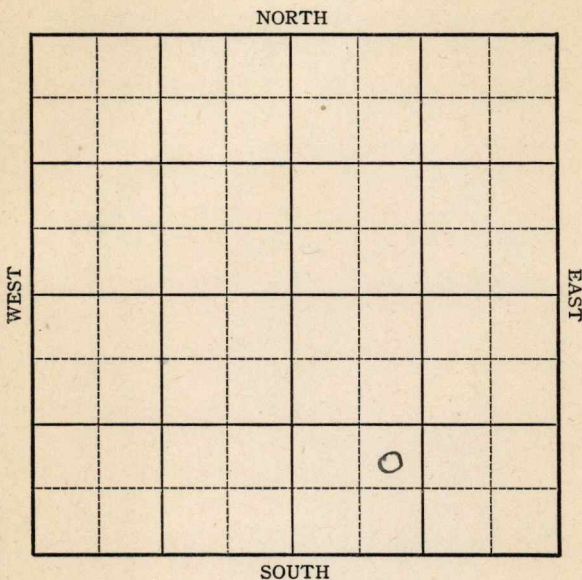


Sec. 17 Twp. 16 R. 1-W

Well No. #2 E. Tressin Farm

Deep Rock Company

NORTH

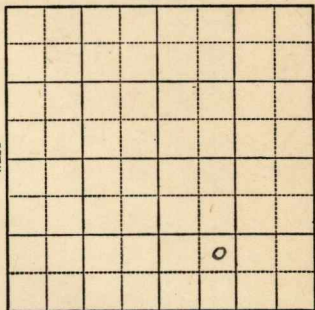

_____ Ft. from N. Line

990 Ft. from S. Line

_____ Ft. from E. Line

990 Ft. from W. Line

Elev. 1347

1943

R E P O R T

11/24 10" @ 130'
Drlg. 1076'

12/1 **Miss 2678-79 TD**
6" @ 2678
RUST

12/8 TD 2682'
12-15 " "

12/22 PB 2685
3000 acid

12/29 " "

1944
1-5 " "

1-12 " "

1/19 " "

1/26 " "

2/2 Drlg. 3365

2/8 **Hunton 3030**
Viola 3251
Simp 3350
Arb 3416

2/15 TD 3459
SB

2/23 "

3/1 "

OVER

1944

3/8 TD 3459 SD

3/16 " " "

3/22 " " "

3/29 Arb 3416
TD 3459

ABANDONED

KANSAS

Map No. 42 Sec. 17 Twp. 16 R. 1W

Well No. 2 E. Tressin

Deep Rock Company

ABANDONED Contractor

NE SW SE

SECTION PLAT

			o

Ft. from N. Line

990 Ft. from S. Line

Ft. from E. Line

990 Ft. from W. Line

Hunter Pool

Location _____

Rig up _____

Drilling and Remarks:

CR 43416

RECORD

Cased _____ in., _____ ft.

Sand _____

Gas _____

Oil _____

Total Depth 3459

PRODUCTION

1st 24 hrs. Nat. _____

1st 24 hrs. after shot _____

Gas _____ Cu. Ft.

Dry Hole _____

Abandoned _____

Date

MAR 29 1944 19

S. J. LEWIS Scout