


Section 19 Township 16 Range 1W

Well No. #1 Redden

Company Sheldon-West & Salina Drlg.

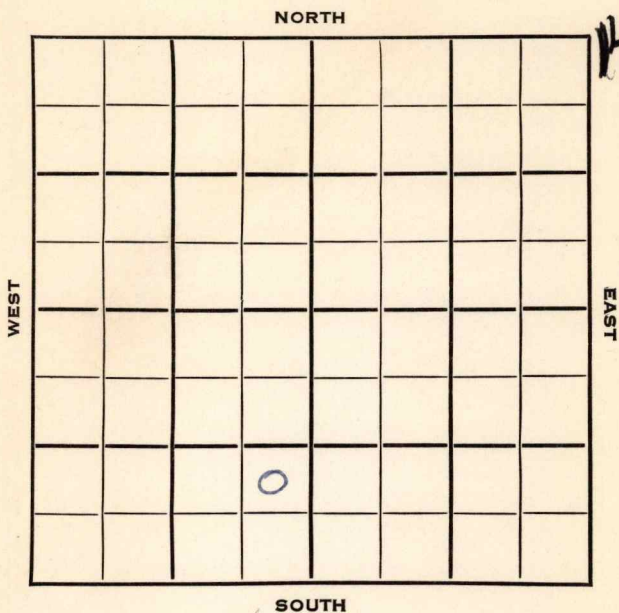

Sec. 19 Twp. 16 R. 1W

Well No. #1 Radden Farm

Sheldon-West & Salina Drlg Company

Salina Drlg. Contractor

Hunter Pool


_____ Ft. from N. Line

990 Ft. from S. Line

330 Ft. from E. Line

_____ Ft. from W. Line

NE SE SW

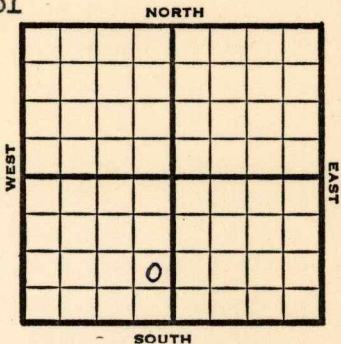

1953

Elev. 1354' REPORT

4/29

Spud 4-22-53

8" @ 156'

Doug 1782

DST 1772-86 open $\frac{1}{2}$ hr, rec 5' ocm Off

DST 1791-96 open $\frac{1}{2}$ hr. rec 180' wtr. 780#.

Drlg 2235'

5/7

NR

5/13

Spud 4-22-53

D & A

TD 2735'

8" @ 156'

Heeb 1858, Tor. 1873, Doug 1876

DST 1876-83 opn 40 min, rec 3' o & gcm Off SO 1897-1906

DST 1896-1920 opn $\frac{3}{4}$ hr, rec 195' sw 775# **Dodge 2039, Lans 2093, Miss 2681,**

Miss. Lime 2682

DS^T 2721-26 opn 1 hr, rec 210' sw 850#

TD 2735'

5" @ 2265'

CO to 2228'

24/ 2219-24 FU 600' sw PB 1906 20/

1900-04 PB 1891 20/ 1881-87

FU 1200' sw & VSSO

D & A.

ABANDONED

County Saline State Kansas

Sec. 19 (Blk. 16 (Sur. Rge.) 1W) Map No.

Operator Sheldon-West & Salina Drlg.

Well No. 1 Farm Redden

Elev. _____ Location NE SE SW

990 Ft. From S Line SW

330 Ft. From E Line Quarter

1st. Report APR 29 1953

Completion _____

Remarks _____

Salina Drlg. - Contr.

Spudding Date 4-22-53

Drlg. Data Hunter Pool

8" @ 156 Doug. 1782 DST 1772-86

open 1/2 hr. Rec. 5' ocm 0# DST 1791-96

open 1/2 hr. Rec. 180' wtr. 780#

drlg. 2235

County Saline State Kansas

Sec. 19 (Blk. Twp.) 16 (Sur. Rge.) 1W Map No.

Operator Sheldon-West & Salina Drlg.

Well No. 1 Farm Redden

Elev. 1354 Location NE SE SW



990 Ft. From S Line SW

330 Ft. From E Line Quarter

1st. Report

Completion MAY 13 1953

Remarks Hunter Pool

Salina Drlg. - Contr.

Spudding Date 4-22-53

Drlg. Data D & A TD 2735

8" @ 156 Heeb. 1858 Tor. 1873

Doug. 1876 DST 1876-83 open 40 min.

Rec. 3' o & gcm 0# SO 1897-1906

DST 1896-1920 open 3/4 hr. Rec. 195' sw

775# Dodge 2039 Lans. 2093 Miss. 2681

Miss. lime 2682 DST 2721-26 open 1 hr.

Rec. 210' sw 850# TD 2735 5" @ 2265

CO to 2228 24/ 2219-24 FU 600' sw

PB 1906 20/ 1900-04 PB 1891 20/ 1881-

87 FU 1200' sw & VSSO

D & A