

KANSAS


Saline

FORM 51 5M 1-42 PETROL

Section 19 Township 16 Range 1-W

Well No. #2 Threlkeld

Company Deep Rock

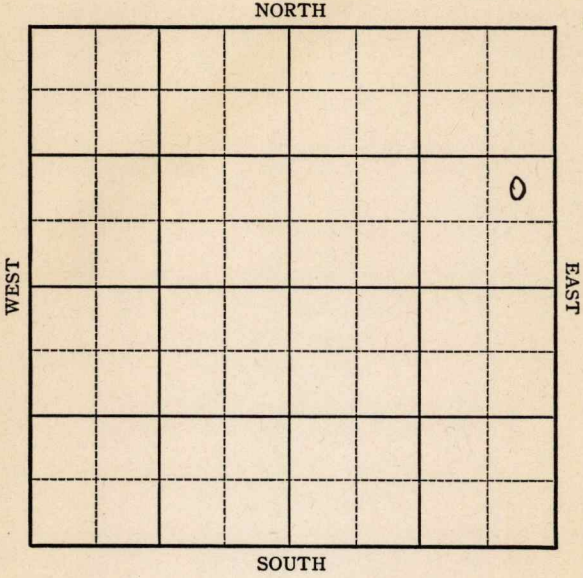

**KANSAS** Saline

Sec. 19 Twp. 16 R. 1-W

Well No. #2 Threlkeld Farm

Deep Rock Company


Hunter

\_\_\_\_\_ Ft. from N. Line

990 Ft. from S. Line

330 Ft. from E. Line

\_\_\_\_\_ Ft. from W. Line

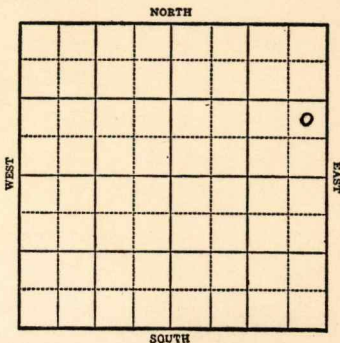

1943

R E P O R T

5/12 Location.

5/19 10" @ 104  
Drlg. 1685

5/26 **Miss 2707**  
T.D. 2712  
7" @ 2709 Rust

6/2 Pay 2720-22T.D.  
70' oil per hr.

6/9 T. D. 2748 S.W.  
PB 2729

6/16 " "

6/23 **Miss. 2707**  
7" @ 2709'  
T.D. 2748'  
P.B. 2729'  
Pump 35 oil plus 75 water Pot.  
Gravity 36

**COMPLETED**

Saline

Map No. **KANSAS** / 2 Sec. **19** Twp. **16** R. **1W**

Well No. **2 Threlkeld**

**Deep Rock** Company

**COMPLETED** Contractor

NE SE NE

SECTION PLAT

\_\_\_\_\_ Ft. from N. Line

**990** Ft. from S. Line

**330** Ft. from E. Line

\_\_\_\_\_ Ft. from W. Line

			o

**HUNTER POOL**

Location \_\_\_\_\_

Rig up \_\_\_\_\_

Drilling and Remarks:

*Miss 2707*

*7" C 2709*

*PB 2729*

*Pump 35 oil + 25 Water  
Pot.*

*26 = 42*

RECORD

Cased \_\_\_\_\_ in., \_\_\_\_\_ ft.

Sand \_\_\_\_\_

Gas \_\_\_\_\_

Oil \_\_\_\_\_

Total Depth **2745**

PRODUCTION

1st 24 hrs. Nat. \_\_\_\_\_

1st 24 hrs. after shot \_\_\_\_\_

Gas \_\_\_\_\_ Cu. Ft.

Dry Hole \_\_\_\_\_

Abandoned \_\_\_\_\_

Date

**JUN 23 1943**

19

**S. J. LEWIS** Scout

Saline

Map No. KANSAS 2 Sec. 19 Twp. 16 R. 1W

Well No. 2 Threlkeld

Deep Rock Company

FIRST REPORT Contractor

NE SE NE

SECTION PLAT

           Ft. from N. Line

990 Ft. from S. Line

330 Ft. from E. Line

           Ft. from W. Line

			o

HUNTER POOL

Location XXX

Rig up           

Drilling and Remarks:           

RECORD

Cased            in.,            ft.

Sand           

Gas           

Oil           

Total Depth           

PRODUCTION

1st 24 hrs. Nat.           

1st 24 hrs. after shot           

Gas            Cu. Ft.

Dry Hole           

Abandoned           

Date

MAY 12 1943 19

S. J. LEWIS Scout