


Section 28 Township 34 Range 2E

Well No. .1 Wolf

Company ~~Kriswell~~ E.H. Riggs Ashton Oil

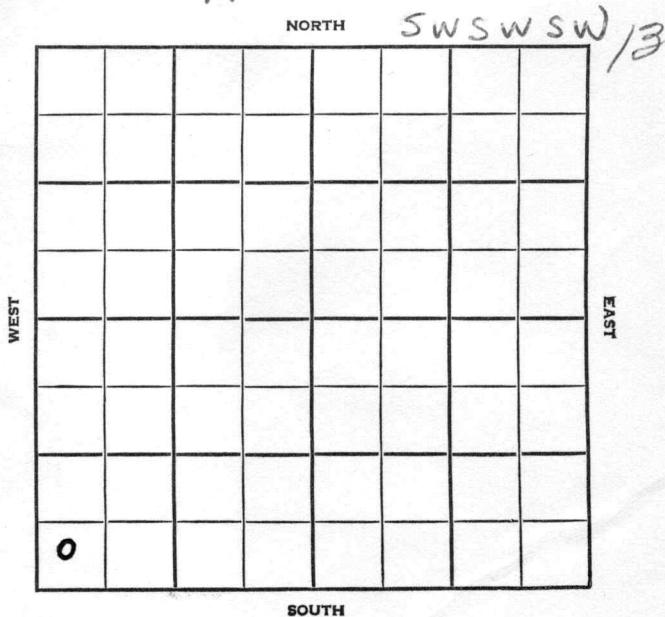

O. W. D. D

Sumner

KANSAS

SEC.	TWP.	R.
28	34	2 E

WELL NO.

1 Wolf

FARM

COMPANY

CONTRACTOR

~~XX~~ Kirkpatrick

Dyal Pool


_____ Ft. from N. Line

330 _____ Ft. from S. Line

_____ Ft. from E. Line

330 _____ Ft. from W. Line

SW SW SW

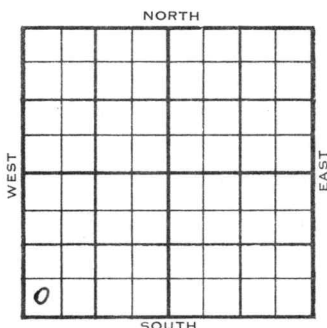

	ELEVATION	REPORT
1954	1196'	

8/4 Location

11/23 Spud 9-28-54 - Oil Well

TD 3510'

8-5/8" @ 100'

Stal. 2415', Layton 2840', Cleve
3166', Chat 3499'

TD 3510'

DST 2837-45, opn 45", rec. 15' mud,
950#DST 3502-10', opn 1 hr., rec. 25' oil,
60' ocm, 2200' gas, 850#

5" @ 3502'

CO to TD

B/2 boph

P/1 boph

Comp. 25 bopd

COMPLETED

County **Sumner** State **Kansas**

Sec. **28** (Blk. **34** (Sur. **2E** Map No.

Operator **Kriswell**

Well No. **1** Farm **Wolf**

[illegible]

0

FIRST REPORT

330 Ft. From S Line SW

330 Ft. From W Line Quarter

1st. Report AUG 4 1954

Completion

Remarks

Spudding Date

Drlg. Data Dyal Pool


Location

J. G. McGEHEE

Map No. _____ Sec. 28 Twp. 34 R. 2EWell No. 1 WolfAshton Oil Company**CORRECTION**_____
Contractor

SW SW SW

SECTION PLAT

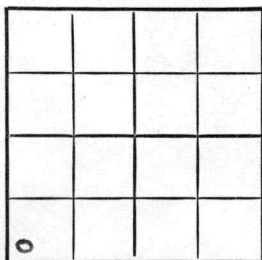Ft. from N. Line330 Ft. from S. Line_____
Ft. from E. Line330 Ft. from W. LineSumner Co.

Location _____

Rig up _____

Drilling and Remarks:

Reported

Kriswell

RECORD

Cased _____ in., _____ ft.

Sand _____

Gas _____

Oil _____

Total Depth _____

PRODUCTION

1st 24 hrs. Nat. _____


1st 24 hrs. after shot _____

Gas _____ Cu. Ft.

Dry Hole _____

Abandoned _____

Date _____

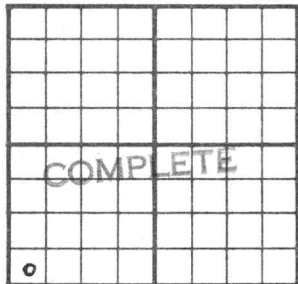County Sumner State KansasSec. 28 (Blk.
Twp.) 34 (Sur.
Rge.) 2E Map No.Operator Ashton OilWell No. 1 Farm WolfElev. 1196 Location SW SW SW330 Ft. From S Line SW330 Ft. From W Line Quarter

1st. Report

Completion NOV 23 1954Remarks Dyal PoolKirkpatrick - Contr.Spudding Date 9-28-54Drig. Data Oil well TD 35108 5/8" @ 100 Stal. 2415 Layton 2840Cleve. 3166 Chat. 3499 TD 3510DST 2837-45 open 45 min. Rec. 15' mud950# DST 3502-10 open 1 hr. Rec. 25'oil 60' ocm 2200' gas 850#5" @ 3502 CO to TD B/ 2 boph P/ 1 bophComp. 25 bopd

FABEN GILSTRAD

A W. D. D

County Sumner Elev. 1196 DF
 Sec. 28 Twp. 34 Rge. 2E
 Company E. H. Riggs
 Farm Name Wolf No. 1

TOPS	DEPTH	LOG	DATUM	Loc. in Sec.
Anh.				SW SW SW
Tr.				(OWDD)
stal	2415			
Dg.				
Bl.				
L.	layton	2845		
K.C.				Geol.
B.K.C.				Contr.
Ce.				
C.				
M.	3489			
M.				Pool
K.				Padgett W.
Mz.				
Me.				
V.				
S.				
S.				
A.				
R.				
Pe.				
G.				
OTD	2510			

Date Comm. Old Info. 5" @ 2502, P/50 bopd +
 tr wtr. Old Operator was Ashton.

New Info - MICT & CO TD DD

29

County Sumner Elev. 1196 DF
 Sec. 28 Twp. 34 Rge. 2E
 Company E. H. Riggs
 Farm Name Wolf No. 1

TOPS	DEPTH	LOG	DATUM	Loc. in Sec.
Anh.				SW SW SW
Tr.				(OWDD)
H.				
Tr. stal	2415			
Dg.				
BL.				
L. layton	2845			
K.C.				Geol.
B.K.C.				Contr.
Ce.				
C.				
M.	3489			
M.				Pool
K.				Padgett W.
Mz.				
Mo.				
V.				
S.				
S.				
A.				
R.				
Pe.				
G.				
T.D. OTD	3510			

Date Comm. Old Info. 5" @ 2502, P/50 bond +
 tr wtr. Old Operator was Ashton.

New Info - MICT & CO TD DD JUL 31 '57 OD

3521 & 7 1/2 Bwph AUG 9 '57 S.O. AUG 14 '57

AUG 21 '57 PB 3512 S 1 BFPH 50% and

AUG 28 '57 SEP 4 '57

Temp Add.