

KANSAS

FORM 51 5M 4-41 PETROL

Barton

Section 26 Township 16 Range 13-W

Well No. 2 Kultgen


Company Stanolind

Ainsworth Pool

NORTH

WEST

EAST

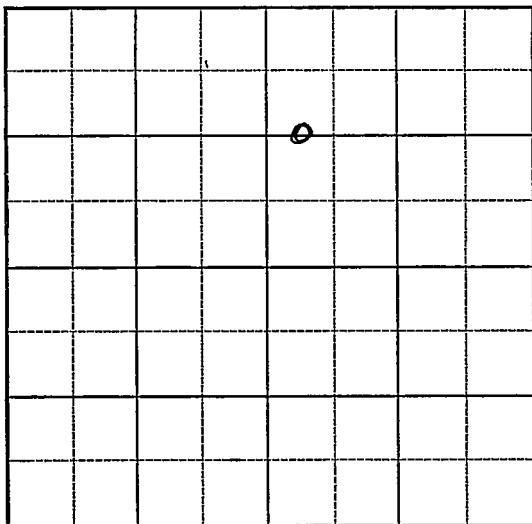

SOUTH

Sec. 26 Twp. 16 R. 13-W

Well No. #2 Kultgen Farm

Stanolind

Company

(Ainsworth)


1320 Ft. from N. Line

_____ Ft. from S. Line

_____ Ft. from E. Line

330 Ft. from W. Line

Elev. 1950

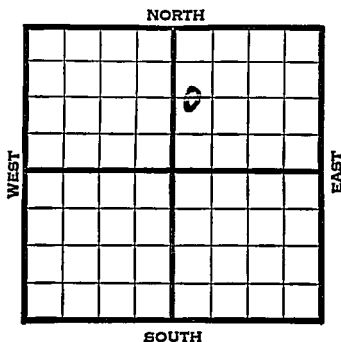

1941	REPORT
5/7	Location
5/15	"
5/22	"
5/28	Derrick.
6/5	"
6/12	8" - 247' Anhy 880'
	Drig. 2016'
6/19	Lans. 3195' Arb. 3415-22' ³⁴¹² T.D.
	Run casing.
6/26	4" - 3415 ³⁴¹⁷ T.D. 3422 ³⁴¹⁹ 500 acid
	Swab 80 oil in 3 hours.
7/1	Arb. 3412' (Corrected)
	4" - 3412'
	T.D. 3419'
	Depthograph potential 1114 bbls.
	37.5 Gravity
	COMPLETED

Map No. 73 Sec. 26 Twp. 16 R. 13WWell No. 2 KultgenStanolind Company~~FIRST REPORT~~ ContractorC W L $W\frac{1}{2}$ NE

SECTION PLAT

1320 Ft. from N. Line

_____ Ft. from S. Line

_____ Ft. from E. Line

330 Ft. from W. Line

AINSWORTH POOL

Location X

Rig up _____

Drilling and Remarks:

RECORD

Cased _____ in., _____ ft.

Sand _____

Gas _____

Oil _____

Total Depth _____

PRODUCTION

1st 24 hrs. Nat. _____

1st 24 hrs. after shot _____

Gas _____ Cu. Ft.

Dry Hole _____

Abandoned _____

Date

MAY 7 1941 19 S. J. LEWIS Scout

Map No. _____ Sec. 26 Twp. 16 R. 13W

Well No. 2 Kultgen

Stanolind Company

Contractor

COMPLETED

SECTION PLAT

C W L W $\frac{1}{2}$ NE

1320 Ft. from N. Line

_____ Ft. from S. Line

_____ Ft. from E. Line

330 Ft. from W. Line

AINSWORTH POOL

		o	

RECORD

Location _____

Cased _____ in., _____ ft.

Rig up _____

Sand _____

Drilling and Remarks:

Gas _____

*Corr & 3412 corrected
4 @ 3412*

Oil _____

Total Depth 3419

Depth 34114

PRODUCTION

1st 24 hrs. Nat. _____

1st 24 hrs. after shot _____

Gas _____ Cu. Ft.

Dry Hole _____

Abandoned _____

375

Date

JUL 1 1941

S. J. LEWIS Scout