


Section 19 Township 16 Range 1W

Well No. #1 Agin

Company W. R. Justice

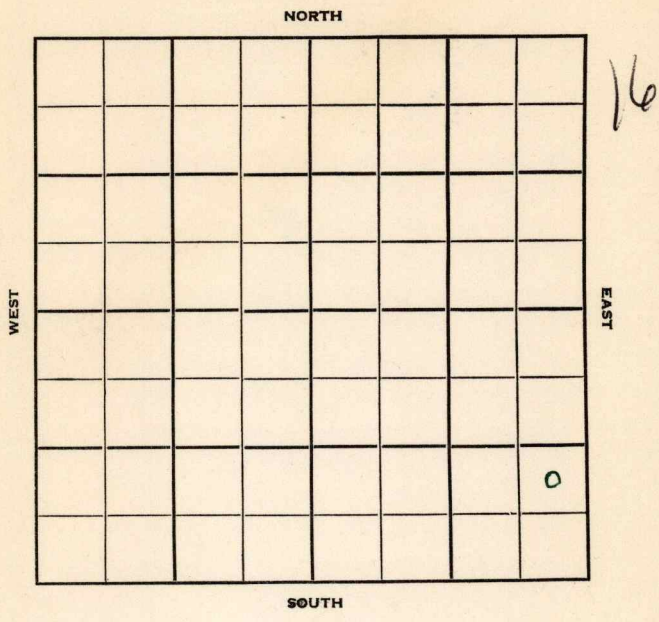

Saline

KANSAS

Sec. 19 Twp. 16 R. 1W

Well No. #1 Agin Farm

W. R. Justice Company

Eckland Drlg. - Contr. Contractor

Hunter Pool


_____ Ft. from N. Line

990' Ft. from S. Line

330' Ft. from E. Line

_____ Ft. from W. Line

NE SE SE

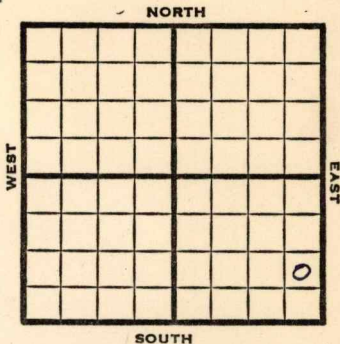

1951

Elev. 1342'

REPORT

11/21

Spud 11-16-51
8" @ 145
Drlg. 1940

1952
1/9

Spud 11-16-51
Oil well TD 2687' 8" @ 145'
Miss 2672' TD 2674' 5" @ 2672'
DD 2687'
Comp. 75 BOPD

COMPLETED

