


Russell

KANSAS

Section 26 Township 14 Range 13-W


Well No. 5 Letsch

Company Texon

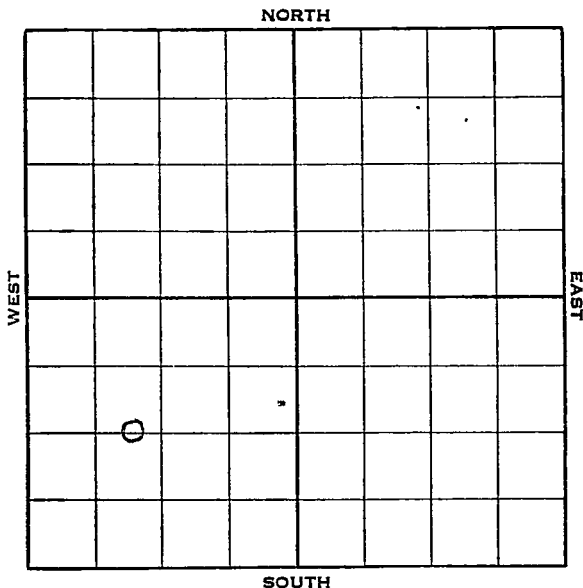

Sec. 26 Twp. 14 R. 13-WWell No. #5 Letsch FarmTexon Company       Ft. from N. Line1320 Ft. from S. Line       Ft. from E. Line990 Ft. from W. Line

Elev. 1679

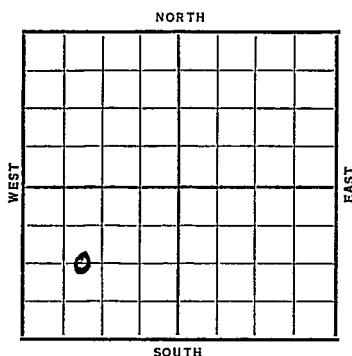

Date

REPORT

1938

2/9

Cellar.

2/18

Drlg. 305'.

2/25

" "

4/3

L.C. 2796'. 7" @ 2814'.

T.D. 2817'. RUST.

No shows reported.

3/11

T.D. 2850'.

Best Pay 2820-50'.

2000' oil.

3/16

7" @ 3814'.

K.C. 2796'.

Pay 2820-50'.

T.D. 2850'.

7000 acid.

Pumped 105 1st hr.

67 2nd hr.

Pumped &amp; flowed 248 bbls. 3rd hr.

327 bbls. 4th hr.

Last 4 hrs. pinched flow to  
150 bbls. per hour.

Potential 3200 bbls.

COMPLETED

Map No. \_\_\_\_\_ Sec. 26 Twp. 14 R. 13WWell No. 5 LetschTexon

Company \_\_\_\_\_

Contractor \_\_\_\_\_

**FIRST REPORT****C E L W $\frac{1}{2}$  SW****SECTION PLAT**

|   |  |  |  |
|---|--|--|--|
|   |  |  |  |
|   |  |  |  |
|   |  |  |  |
| 0 |  |  |  |

\_\_\_\_\_ Ft. from N. Line

1320 Ft. from S. Line

\_\_\_\_\_ Ft. from E. Line

990 Ft. from W. Line

Location \_\_\_\_\_

Rig up \_\_\_\_\_

Drilling and Remarks:

**Cellar****RECORD**

Cased \_\_\_\_\_ in., \_\_\_\_\_ ft.

Sand \_\_\_\_\_

Gas \_\_\_\_\_

Oil \_\_\_\_\_

Total Depth \_\_\_\_\_

**PRODUCTION**

1st 24 hrs. Nat. \_\_\_\_\_

1st 24 hrs. after shot \_\_\_\_\_

Gas \_\_\_\_\_ Cu. Ft.

Dry Hole \_\_\_\_\_

Abandoned \_\_\_\_\_

Date

FEB 9 1938 19 H. D. Hatfield Scout

Russell KANSAS

Map No. 72 Sec. 26 Twp. 14 R. 13WWell No. 5 LetschTexon

Company

Contractor

COMPLETE

C E L  $W\frac{1}{2}$  SW

Ft. from N. Line

1320 Ft. from S. Line

Ft. from E. Line

990 Ft. from W. Line

## SECTION PLAT

|   |  |  |  |
|---|--|--|--|
|   |  |  |  |
|   |  |  |  |
|   |  |  |  |
| 0 |  |  |  |
|   |  |  |  |

Location

Rig up

Drilling and Remarks:

7000 Acid

Pumped 105 1st hr

67 2nd hr

Pumped &amp; Flowed 248-3rd

327-4th

Last 4hrs pinched Flow

To 150 bbls Per hr

POT 3240

## RECORD

Cased 7 in., 2814 ft.Sand K.C. 2796Gas Pzy 2820-50

Oil

Total Depth 2850

## PRODUCTION

1st 24 hrs. Nat.

1st 24 hrs. after shot

Gas Cu. Ft.

Dry Hole

Abandoned

Date

MAR 16 1938

19

E. D. Hatfield

Scout