

WEST

EAST

SOUTH

Drilling Remarks:

Drilling Remarks:

RECORD

Cased_____ in._____ ft.

Sand _____

Gas _____

Oil, _____

Total Depth

PRODUCTION

1st 24 hrs. Nat. _____

1st 24 hrs. after shot_____

Gas _____ cu. ft.

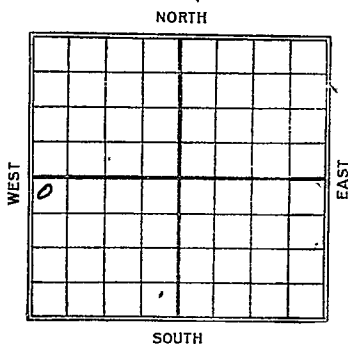
Dry Hole _____

Abandoned_____

Map No. ✓ 29 Sec. 34 Twp. 2 R. 2Well No. 1- Ward (WORK) Farm
Phillips Pet. Company200 Ft. from N. Line

_____ Ft. from S. Line

_____ Ft. from E. Line

200 Ft. from W. Line

REPORT

~~1924~~
 3/14 Bury
 4/24 Slg @ 1000'
 7/16 Slg. @ 3005'
 10/17 " " 3635'
 12/17 Wilcox 3785' - H.F.W. 3800'
Top Line 3506'
Slg. 3945'
 1925
 1/14 ~~Top~~
 1/14 Top Line 3506
Top Wilcox 3785' H.F.W.
S. & A. @ 4001'

Map No. **KANSAS** Sec. 29 Twp. 34 R. 2 EWell No. #1 WarkP Phillips Pet Company

Contractor

FIRST REPORT**SECTION PLAT**200 Ft. from N. Line

_____ Ft. from S. Line

_____ Ft. from E. Line

200 Ft. from W. Line

●			

Location _____

Rig up _____

Drilling and Remarks:

Rig Bldg**RECORD**

Cased _____ in., _____ ft.

Sand _____

Gas _____

Oil _____

Total Depth _____

PRODUCTION

1st 24 hrs. Nat. _____

1st 24 hrs. after shot _____

Gas _____ Cu. Ft.

Dry Hole _____

Abandoned _____

Date

MAR 14 1924M. A. BENEAR192

Scout


Contractor

ABANDONED

SECTION PLAT

200 Ft. from N. Line

Ft. from S. Line

Ft. from E. Line

200 Ft. from W. Line

0			

Location

Rig up

Drilling and Remarks:

Tap Line 3506**Tap Wire 3785****N.F. W. @ 3700****L.O. & A @ 4000'**

RECORD

Cased _____ in., _____ ft.

Sand _____

Gas _____

Oil _____

Total Depth _____

PRODUCTION

1st 24 hrs. Nat. _____

1st 24 hrs. after shot _____

Gas _____ Cu. Ft.

Dry Hole _____

Abandoned _____

Date

M. A. BENEAR**1/14****5** 192

Scout

MAP NO. K1 KANSAS SEC. 7A TWP. 34S R. 2E

WELL NO. 1 Hook

Phillips COMPANY

CONTRACTOR

ABANDONED

SECTION PLAT

0			

_____ FT. FROM N. LINE

_____ FT. FROM S. LINE

_____ FT. FROM E. LINE

_____ FT. FROM W. LINE

LOCATION _____

RIG UP _____

DRILLING AND REMARKS:

RECORD

CASED _____ IN. _____ FT.

SAND _____

GAS _____

OIL _____

TOTAL DEPTH 4001

PRODUCTION

1ST 24 HRS. NAT. _____

1ST 24 HRS. AFTER SHOT _____

GAS _____ CU. FT.

DRY HOLE ☒

ABANDONED ☒

DATE

1-26-5 192

SCOT