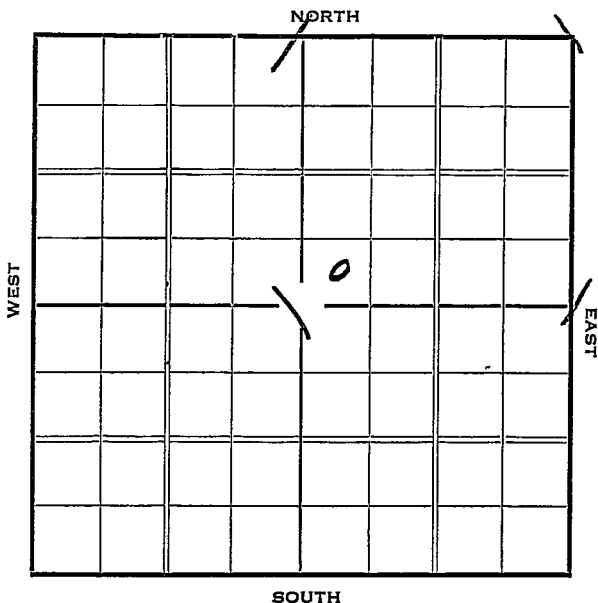


Section 26 Township 16 Range 13-WWell Number #1 L. KultgenCompany Stanolind

1937

12/8

7" @ 3406'.

Sil. 3406'.

T.D. 3429'.

Shot 20 qts. 3409-15'.

300 acid.

Pot. 54 bbls. but completed for
a 15 bbl. minimum well.

COMPLETED

Barton **KANSAS**Map No. _____ Sec. 26 Twp. 16 R. 13WWell No. 1 L. KultgenStanolind Company

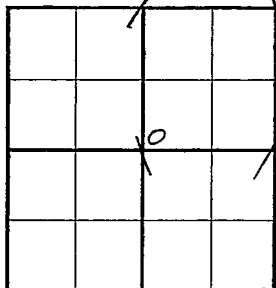
Contractor _____

FIRST REPORT**SW NE**

_____ Ft. from N. Line

330 Ft. from S. Line

_____ Ft. from E. Line

330 Ft. from W. Line**SECTION PLAT**

Location _____

Rig up _____

Drilling and Remarks:
RR**RECORD**

Cased _____ in., _____ ft.

Sand _____

Gas _____

Oil _____

Total Depth _____

PRODUCTION

1st 24 hrs. Nat. _____

1st 24 hrs. after shot _____

Gas _____ Cu. Ft.

Dry Hole _____

Abandoned _____

Date

OCT 13 1937 19 H. D. Hatfield Scout

Barton **KANSAS**Map No. _____ Sec. **26** Twp. **16** R. **13W**Well No. **1 L. Kultgen**_____ **Stanolind** _____ Company

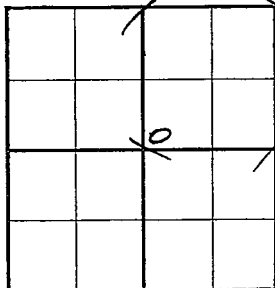
_____ Contractor

COMPLETED**SW NE**

_____ Ft. from N. Line

330 _____ Ft. from S. Line

_____ Ft. from E. Line

330 _____ Ft. from W. Line**SECTION PLAT**

Location _____

Rig up _____

Drilling and Remarks:

*shot 20 qts 3409-15
300 acid
Pot. 54 bbls but
completed for a
15-bbl minimum
well*

RECORDCased 7 in., 3406 ft.Sand 511 3406

Gas _____

Oil _____

Total Depth 3429**PRODUCTION**

1st 24 hrs. Nat. _____

1st 24 hrs. after shot _____

Gas _____ Cu. Ft.

Dry Hole _____

Abandoned _____

Date

DEC 8 - 1937 19**E. D. Hatfield** Scout