

KANSAS


Saline

FORM 51 5M 1-42 PETROL

Section 20 Township 16 Range 1-W

Well No. #1 R. A. Hunter

Company Deep Rock

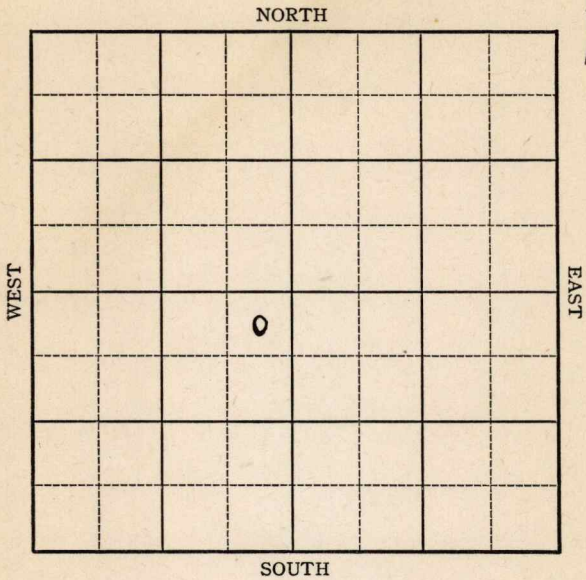

Sec. 20 Twp. 16 R. 1-W

Well No. #1 R. A. Hunter Farm

Deep Rock Company

Hunter


330 Ft. from N. Line

\_\_\_\_\_ Ft. from S. Line

330 Ft. from E. Line

\_\_\_\_\_ Ft. from W. Line

*elev. 1336*

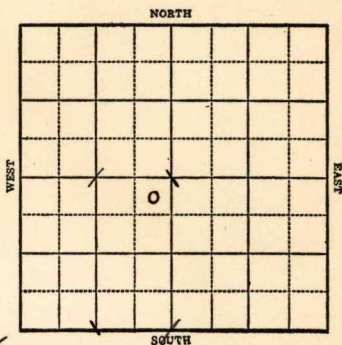

1943

R E P O R T

- 5/26 Rotary
- 6/2 10" @ 94  
Drlg. 1620'
- 6/9 **Miss 2668**  
7" @ 2669  
T. D. 2670 Rust
- 6/16 T.D. 2676-2000' oil  
SW in 16 hrs.
- 6/23 1000 acid  
Pump 20 oil per hr. 2% water.
- 6/30 **Miss. 2668**  
7" @ 2660  
T.D. 2676'  
1000 gal acid  
Pump 458 oil plus 4% Water  
Gravity 36

**COMPLETED**

**KANSAS**

**Saline**

Map No. 42 Sec. 20 Twp. 16 R. 1W

Well No. 1 R. A. Hunter

Deep Rock Company

**COMPLETED** Contractor

NE SW

SECTION PLAT

330 Ft. from N. Line

\_\_\_\_\_ Ft. from S. Line

330 Ft. from E. Line

\_\_\_\_\_ Ft. from W. Line

	o		

**HUNTER POOL**

**RECORD**

Location \_\_\_\_\_

Cased \_\_\_\_\_ in., \_\_\_\_\_ ft.

Rig up \_\_\_\_\_

Sand \_\_\_\_\_

Drilling and Remarks:

Gas \_\_\_\_\_

*Miss 2668.*

Oil \_\_\_\_\_

*7" @ 2669*

Total Depth 2676

*1000 Gall*

**PRODUCTION**

*Pump 458 oil + 4% gas*

1st 24 hrs. Nat. \_\_\_\_\_

1st 24 hrs. after shot \_\_\_\_\_

Gas \_\_\_\_\_ Cu. Ft.

Dry Hole \_\_\_\_\_

Abandoned \_\_\_\_\_

*36° SW*

Date

JUN 3 0 1943 19

S. J. LEWIS Scout

Saline

KANSAS

Map No. 42 Sec. 20 Twp. 16 R. 1W

Well No. 1 R. A. Hunter

Deep Rock

Company

FIRST REPORT

Contractor

NE SW


SECTION PLAT

330 Ft. from N. Line

\_\_\_\_\_ Ft. from S. Line

330 Ft. from E. Line

\_\_\_\_\_ Ft. from W. Line

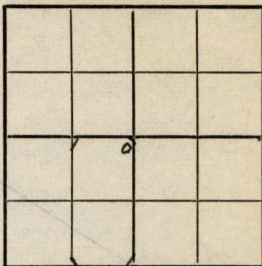

HUNTER POOL

RECORD

Location \_\_\_\_\_

Cased \_\_\_\_\_ in., \_\_\_\_\_ ft.

Rig up \_\_\_\_\_

Sand \_\_\_\_\_

Drilling and Remarks:

Gas \_\_\_\_\_

Oil \_\_\_\_\_

Total Depth \_\_\_\_\_

Rotary

PRODUCTION

1st 24 hrs. Nat. \_\_\_\_\_

1st 24 hrs. after shot \_\_\_\_\_

Gas \_\_\_\_\_ Cu. Ft.

Dry Hole \_\_\_\_\_

Abandoned \_\_\_\_\_

Date

MAY 26 1943 19

S. J. LEWIS Scout