


Section 26 Township 16 Range 13-W

Well No. 1 - L. Redetzke

Company Stanolind

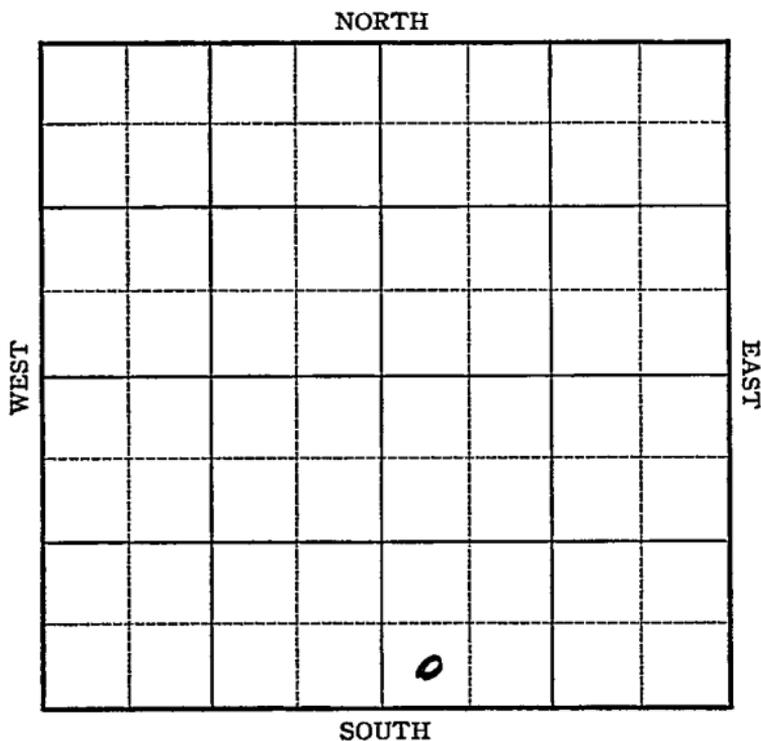

Sec. 26 Twp. 16 R. 13-W

Well No. #1 L Redetzke Farm

Stanolind Company


_____ Ft. from N. Line

330 Ft. from S. Line

_____ Ft. from E. Line

350 Ft. from W. Line

Elev. 1930

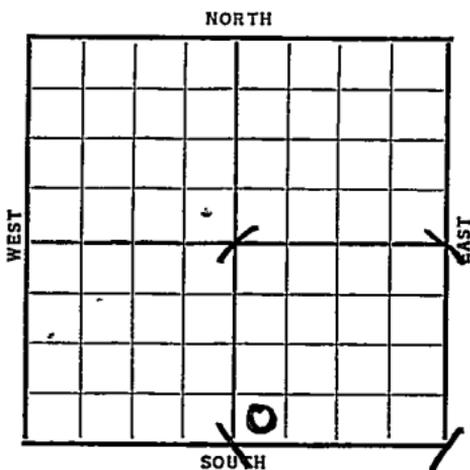

Date	REPORT
1937	
6/16	B.R.R.
7/2	Rig
7/9	R. U.
7/16	12" @ 234'. T.D. 240'. WOC.
7/23	Anhy 840'. Drlg. 2124'.
7/30	Sil. 3400-06' T.D. Rng. 6".
8/6	6" @ 3401'. RUST.
8/13	" " "
8/20	T.D. 3406'. 2100' oil 18 hrs. 2000 acid.
8/28	Swab 8 bbls. oil per hr.
	Cored 3406-09 no increase.
	2000 acid. Swab 70 bbls.
	oil P.H. 2000' off bottom.

OVER

1937

9/1 6" @ 3401'.
Sil. 3400'.
T.D. 3409'.
2000 acid.
2000 acid.
Pot. 1652 bbls.

COMPLETED

...

Barton

Map No. 73 Sec. 26 Twp. 16 R. 13^WWell No. 1 - L. Redetzke.Stanolind Company

Contractor

FIRST REPORT

SECTION PLAT

 Ft. from N. Line330 Ft. from S. Line Ft. from E. Line330 Ft. from W. Line

Location Rig up

Drilling and Remarks:

BRR.

RECORD

Cased in., ft.Sand Gas Oil Total Depth

PRODUCTION:

1st 24 hrs. Nat. 1st 24 hrs. after shot Gas Cu. Ft.Dry Hole Abandoned

Date

JUN 16 1937H. D. Hatfield

Scout

Barton KANSAS

Map No. _____ Sec. *26* Twp. *16* R. *13*^W

Well No. *1 - L. Redetzke*

Standard Company

Contractor

COMPLETED

SECTION PLAT

55 Ft. from N. Line

330 Ft. from S. Line

_____ Ft. from E. Line

330 Ft. from W. Line

Location _____

Rig up _____

Drilling and Remarks:

2000 Acid
2000 -

Pat - 1652

RECORD

Cased *6* in. *3401* ft.

Sand *511 3400*

Gas _____

Oil _____

Total Depth *3409*

PRODUCTION

1st 24 hrs. Nat. _____

1st 24 hrs. after shot _____

Gas _____ Cu. Ft.

Dry Hole _____

Abandoned _____

Date

SEP 1 1937 19

H. D. Hatfield Scout