

Saline

FORM 51


O. W. P. B.

KANSAS

Section 20 Township 16 Range 1W

Well No. #1 Redding

Company Geo. Hess + Larry Moore  
Mallard Drlg.

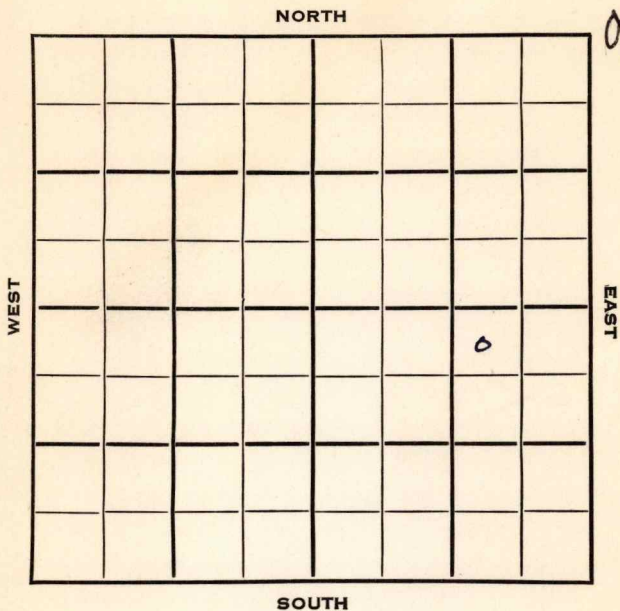

O. W. P. B.

Saline

KANSAS


SEC. 20	TWP. 16	R. 1W ✓
------------	------------	------------

WELL NO. #1 Redding FARM

COMPANY *Geo. Hess + Larry Moore*  
~~Mallard Drlg.~~

CONTRACTOR *O. W. P. B.*  
Mallard Drlg.  
Hunter Pool

330 Ft. from N. Line  
Ft. from S. Line  
990 Ft. from E. Line  
Ft. from W. Line

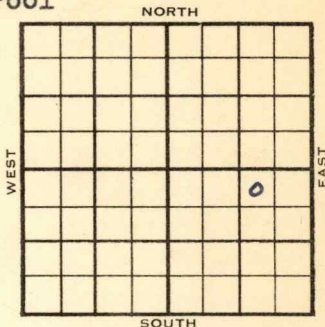

NW NE SE

	ELEVATION	REPORT
1954	1315'	
4/7	Spud 4-4-54 8" @ 140'	Drlg 772'
4/28	Spud 4-4-54 D&A TD 2653' 8" @ 140'	Heeb 1815', Doug 1844', Miss 2635' TD 2640', 500A 500A DD 2648' DD 2653', SSO, 1000A 1/2 bo 7 bwph DST 1844-53', opn 1 hr., rec. 20' mud, SSO D&A
<b>ABANDONED</b>		
1954	<b>O. W. P. B.</b>	
8/25	Doug 1844' Miss 2635'	OTD 2653
	MIR 5" @ 1906	
9/29	D&A TD 2653'	Doug 1844', Miss 2635'
	OTD 2653'	5" @ 1906
	CO to 1874, 40/1844-52, FU 150' wtr	D&A
	<b>ABANDONED</b>	

County **Saline** State **Kansas**

Sec. **20** (Blk. **16**) (Sur. **1W**) (Twp.) (Rge.) Map No.

Operator **Mallard Drlg.**

Well No. **1** Farm **Redding**

Elev. Location **NW NE SE**


**330** Ft. From **N** Line **SE**

**990** Ft. From **E** Line Quarter

Ist. Report **APR 7 1954**

Completion

Remarks

**Mallard Drlg. - Contr.**

Spudding Date **4-4-54**

Drlg. Data **Hunter Pool**

**8" @ 140 drlg. 772**

County Saline State Kansas

Sec. 20 (Blk. 16) (Sur. 1W) (Twp.) (Rge.) Map No.

Operator Mallard Drlg.

Well No. 1 Farm Redding

Elev. 1315 Location NW NE SE



330 Ft. From N Line SE

990 Ft. From E Line Quarter

1st. Report

Completion APR 28 1954

Remarks Hunter Pool

Mallard Drlg. - Contr.

Spudding Date 4-4-54

Drlg. Data D & A TD 2653

8" @ 140 Heeb. 1815 Doug. 1844

Miss. 2635 TD 2640 500 A DD 2648

DD 2653 SSO 1000 A 1/2 bo 7 bwph

DST 1844-53 open 1 hr. Rec. 20' mud SSO

D & A



