

KANSAS


FORM 51 5M 10-41 PETROL

Saline

Section 20 Township 16 Range 1-W

Well No. #1 Reeves

Company Deep Rock

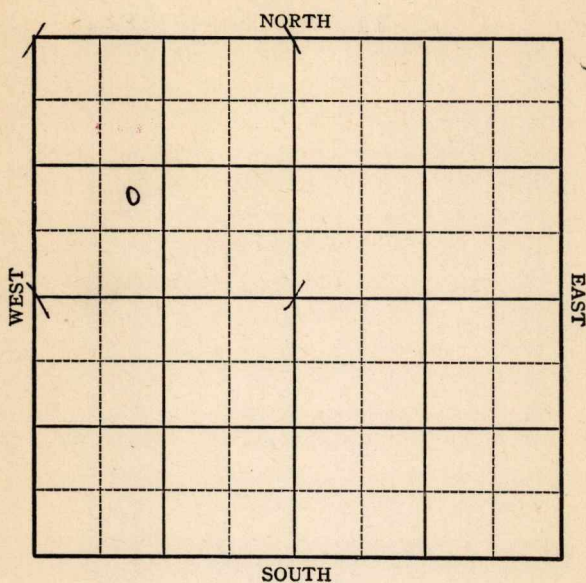

KANSAS

Saline

Sec. 20 Twp. 16 R. 1-WWell No. #1 Reeves FarmDeep Rock Company

Hunter


Ft. from N. Line

990 Ft. from S. Line

Ft. from E. Line

990 Ft. from W. Line

Elev. 1341 (Est)

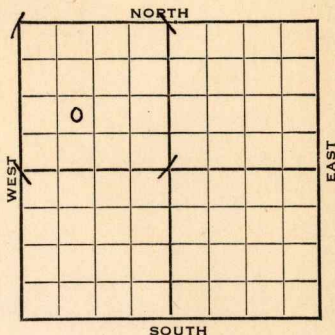

1943

REPORT

3/3 Location.

3/10 "

3/16 Rotary.

3/24 "

3/31 10" @ 134 TD 1212 SD

4/7 Drlg. 2525'

4/14 Douglas 1872

Sat 1872-82

Miss 2670-79 T.D.

7" @ 2676-600' oil in 12 hrs
trace water.

4/21 T.D. 2680-1000' oil

4/28 Swabbed 25 oil in 7 hrs.

5/5 " " " "

5/12 Dr " " " "

5/19 Miss. 2670

7" - 2676

Pump 67 Pot.

T.D. 2680

Gravity 40.

COMPLETED

KANSAS

Map No. 42 Sec. 20 Twp. 16 R. 1WWell No. 1 Reeves

Deep Rock Company

FIRST REPORT Contractor


NE SW NW

SECTION PLAT

_____ Ft. from N. Line

990 Ft. from S. Line

_____ Ft. from E. Line

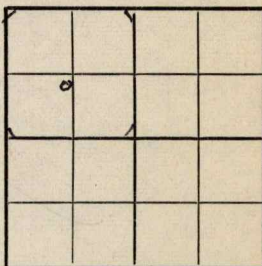990 Ft. from W. Line

HUNTER POOL

Location XXX

Rig up _____

Drilling and Remarks:

RECORD

Cased _____ in., _____ ft.

Sand _____

Gas _____

Oil _____

Total Depth _____

PRODUCTION

1st 24 hrs. Nat. _____

1st 24 hrs. after shot _____

Gas _____ Cu. Ft.

Dry Hole _____

Abandoned _____

Date

MAR 3 1943

19

S. J. LEWIS Scout

KANSAS

Saline

Map No. 42 Sec. 20 Twp. 16 R. 1WWell No. 1 ReevesDeep Rock CompanyCOMPLETED Contractor

NE SW NW

SECTION PLAT

6			

 Ft. from N. Line990 Ft. from S. Line Ft. from E. Line990 Ft. from W. Line

HUNTER POOL

Location Rig up

Drilling and Remarks:

*Mar 2670**7" @ 2676**Pump 67 Bst.**40° Gv*

RECORD

Cased in., ft.Sand Gas Oil Total Depth 2680

PRODUCTION

1st 24 hrs. Nat. 1st 24 hrs. after shot Gas Cu. Ft.Dry Hole Abandoned

Date

MAY 19 1943 19

S. J. LEWIS Scout